

KANSAS


FORM 51 5M 4-41 PETROL

Stafford

Section 27 Township 25 Range 14W

Well No. 3-Kipp "A"

Company Skelly et al

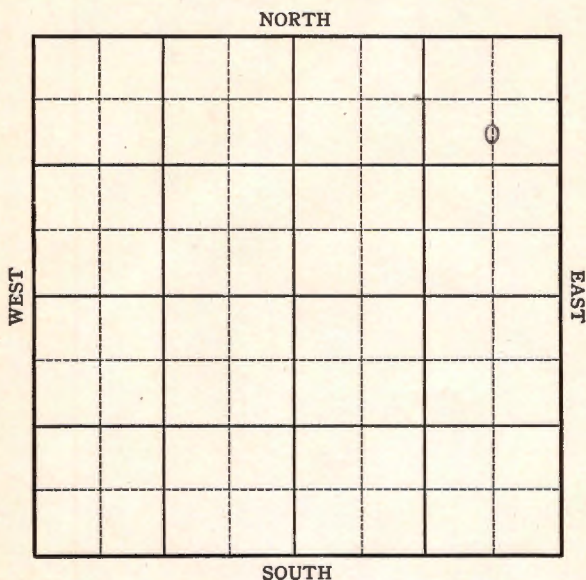


Sec. 27 Twp. 25 R. 14-WWell No. #3 Kipp "A" FarmSkelly et al Company

(Kipp)

990 Ft. from N. Line         Ft. from S. Line660 Ft. from E. Line         Ft. from W. Line

Elev. 1979

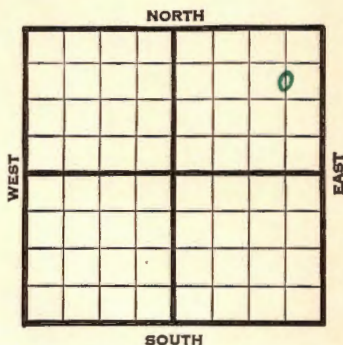

1941

REPORT

9/10

Rotary.

9/18

8" - 397' Drlg. 2135'

9/25

Drlg. 3625'

10/2

Lans. 3672' T.D. 3840'

5" - 3839' RUST.

10/8

Lans. 3672'

5" - 3839'

T.D. 3900'

2500 acid.

Potential 686 bbls., pump.

34.1 Gravity

COMPLETED

Map No. 83 Sec. 27 Twp. 25 R. 14WWell No. 3 Kipp "A"Skelly etal CompanyContractor

## FIRST REPORT

## SECTION PLAT

C SL NE NE

990 Ft. from N. Line       Ft. from S. Line660 Ft. from E. Line       Ft. from W. Line

|  |  |  |   |
|--|--|--|---|
|  |  |  |   |
|  |  |  | o |
|  |  |  |   |
|  |  |  |   |
|  |  |  |   |

## KIPP POOL

Location                     Rig up                     

Drilling and Remarks:

Rotary

## RECORD

Cased            in.,            ft.Sand                     Gas                     Oil                     Total Depth                     

## PRODUCTION

1st 24 hrs. Nat.                     1st 24 hrs. after shot                     Gas                      Cu. Ft.Dry Hole                     Abandoned                     

Date

SEP 10 1941 19S. J. LEWIS Scout

Stafford

KANSAS

Map No. K-83 Sec. 27 Twp. 25 R. 14WWell No. 3 Kipp "A"Skelly et al

Company

COMPLETED

Contractor

C SL NE NE

990 Ft. from N. Line

Ft. from S. Line

660 Ft. from E. Line

Ft. from W. Line

KIPP POOL

## SECTION PLAT

|  |  |  |   |
|--|--|--|---|
|  |  |  |   |
|  |  |  | o |
|  |  |  |   |
|  |  |  |   |
|  |  |  |   |

Location \_\_\_\_\_

Rig up \_\_\_\_\_

Drilling and Remarks:

Lane 36725" @ 38392500 acidPump 686 P.V.341 hr

## RECORD

Cased \_\_\_\_\_ in., \_\_\_\_\_ ft.

Sand \_\_\_\_\_

Gas \_\_\_\_\_

Oil \_\_\_\_\_

Total Depth 3900

## PRODUCTION

1st 24 hrs. Nat. \_\_\_\_\_

1st 24 hrs. after shot \_\_\_\_\_

Gas \_\_\_\_\_ Cu. Ft.

Dry Hole \_\_\_\_\_

Abandoned \_\_\_\_\_

Date

OCT 8 1941 19S. J. LEWIS Scout