


Section 28 Township 25 Range 14 W
Well No. #1 Jordan
Company Alpine O&R

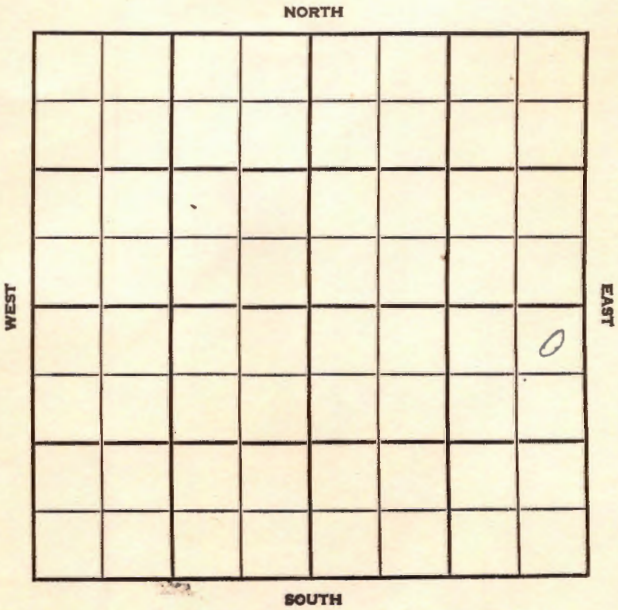

WILDCAT

FORM 513 SUNRAY

County Stafford

Elev. _____

Sec. 28

Twp. 25

Rge. 14 W

Company Alpine O & R

Farm Name Jordan

No. 1

TOPS

DEPTH

LOG

DATUM

Loc. in Sec. _____

Anh.

NENE SE

Tr.

H.

Tr.

Dg.

BL.

L.

K.C.

B.K.C.

Ce.

C.

M.

M.

K.

Mz.

Me.

V.

S.

S.

A.

R.

PE.

G.

T.D.

Geol. _____

Contr. _____

Quaker Tools

Pool

Wildecatt

NOV 28 1956	
FIRST REPORT	

Date Comm. 11-25-56

Skelly DHM

Drlg. surf. hole

26

County Starford Elev. 1989 R13
 Sec. 28 Twp. 25 Rge. 14W
 Company Alpine O & R
 Farm Name Jordan No. 1

TOPS	DEPTH	LOG	DATUM	Loc. in Sec.
Anh.				NENE SE
Tp.				
H.	3535			
Tr.				
Dg.				
Bl.	3684			
L.	3712			Geol.
K.C.				Contr.
B.K.C.	3981			Quaker Tools
Ce.				Kipps S.W.
C.				Phol
M.				Wildcat
M.				
K.				
Mz.				
Mo.				
V.	4119			
S.				
S.	4246			
A.	4292			
R.				
Pe.				
G.				
TD	4295			

COMPLETE

FEB 6 '57

Date Comm. 11-25-56 Skelly DHMDrig. surf. hole DEC 5 '56 11-25-568' 8" 272/325 3525 DEC 12 '56 XDST 3839-60 1hr. G15" rec723' oil FP 150-250 BHP 1200DST 3778-3800 rec 160' MWBHP 1250/ DST 3912-45 34"rec 15' Md BHP 60 DST 4112-301hr G/2.3" rec 30' Md BHP 1430DST 4261-75 or 1hr rec 15' MdBHP 0 5 1/2 @ 4294

DEC 19 '56

DEC 26 '56

MILF

JAN 2 '57

CO 46/

3850-58 FU 3900' oil no/w

No \$ & Flwd 68 Bo no/w

Flwd 114 Bo in 3 hrs no/w

\$ & Flwd 39 Boph no/w 4

hrs gran 30° T&R

JAN 9 '57

POP

JAN 15 '57

JAN 28 '57

JAN 20 '57

FEB 6 '57

Ph P. 475

Bopd no/w gran 34°