


Section 15 Township 25 Range 14-W

Well No. #2 Stimatze

Company Cities Service Oil et al + Atlantic

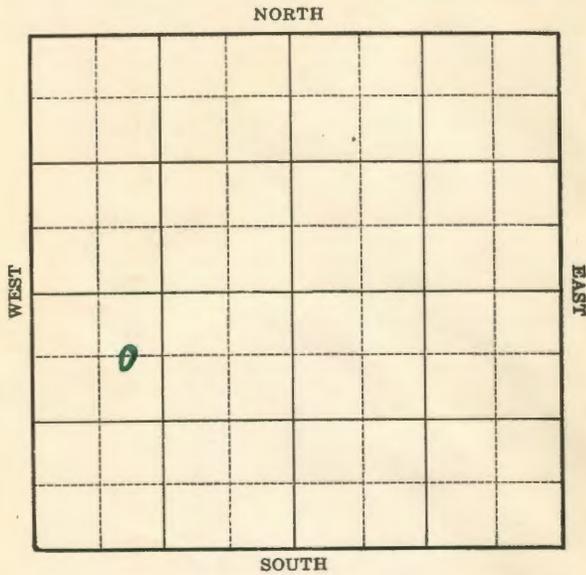

Sec. 15 Twp. 25 R. 14-W

Well No. #2 Stimatze Farm

Cities Service Oil et al + Atlantic Company

(Jordan)

660 Ft. from N. Line


_____ Ft. from S. Line

_____ Ft. from E. Line

990 Ft. from W. Line

CEL NWSW

Elev. 1966

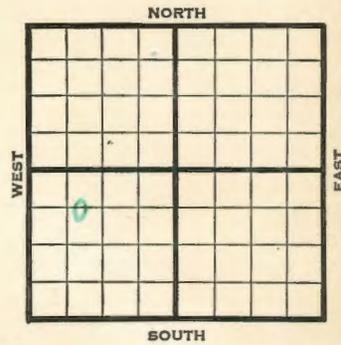

	REPORT
1941	
2/12	Rotary .
2/20	8" - 377' Drlg. 2200'
2/27	Lans. 3613' Drlg. 3755'
3/6	Pay 3777-83 & 3786-94' T.D. 5" - 3773' RUST.
3/13	T.D. 3794' 5000 acid. Flow 38 bbls. oil in 1 1/2 hours.
3/19	Lans. 3613' 5" - 3773' T.D. 3802' 5000 acid. Bomb potential 2910 bbls. plus 90 water. 33. Gravity
	COMPLETED
	OVER

1953
12/2

O.W.W.O.

Oil well TD 3802'
Lans 3613' OTD 3800' 5" @ 3772
PB 3753 33/3742-50 13/3736-39
33/3676-3704 33/3680-88
3000 A
Comp. 1141 BOPD

FIRST REPORT



COMPLETED

Map No. 83 Sec. 15 Twp. 25 R. 14W

Well No. 2 Stimatze

Cities Service Oil etal Company

COMPLETED Contractor

SECTION PLAT

C E L NW SW

660 Ft. from N. Line

Ft. from S. Line

Ft. from E. Line

990 Ft. from W. Line

JORDAN POOL

Location _____

Rig up _____

Drilling and Remarks:

*Lease 3613
5" C 3773
5000 acil
Bon AY 2910
+ 90 Na Tel

334 91*

RECORD

Cased _____ in., _____ ft.

Sand _____

Gas _____

Oil _____

Total Depth 3802

PRODUCTION

1st 24 hrs. Nat. _____

1st 24 hrs. after shot _____

Gas _____ Cu. Ft.

Dry Hole _____

Abandoned _____

Date

MAR 19 1941 19

S. J. LEWIS Scout

Map No. 83 Sec. 15 Twp. 25 R. 14W

Well No. 2 Stimatze

Cities Service Oil etal Company

FIRST REPORT Contractor

SECTION PLAT

C E L NW SW

660 Ft. from N. Line

Ft. from S. Line

Ft. from E. Line

990 Ft. from W. Line

JORDAN POOL

Location _____

Rig up _____

Drilling and Remarks:

Rotary

RECORD

Cased _____ in., _____ ft.

Sand _____

Gas _____

Oil _____

Total Depth _____

PRODUCTION

1st 24 hrs. Nat. _____

1st 24 hrs. after shot _____

Gas _____ Cu. Ft.

Dry Hole _____

Abandoned _____

Date

FEB 12 1941 19

S. J. LEWIS Scout