

KANSAS


Stafford

Form 51-5M-7-40-Palace

Section 16 Township 25 Range 14-W
 Well No. #2 Nieland "B"
 Company Cities Service Oil

NORTH

Kipp Pool

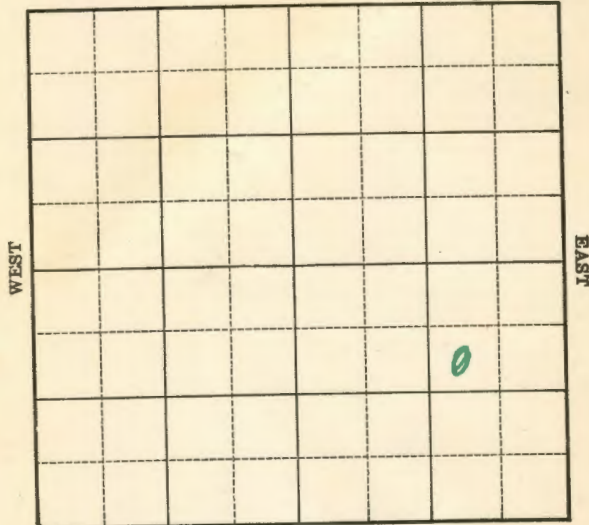

SOUTH

FORM 252-A 5M 7-40 PETROL KANSAS

Stafford

Sec. 16 Twp. 25 R. 14-W
 Well No. #2 Nieland "B" Farm _____
 Cities Service Oil Company _____


(Kipp)

990 Ft. from N. Line

Ft. from S. Line

990 Ft. from E. Line

Ft. from W. Line

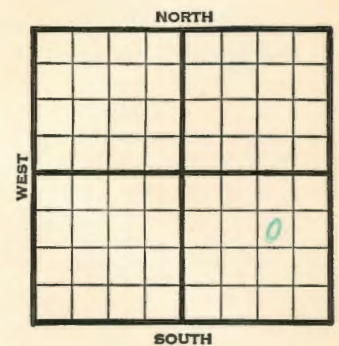

Elev. 1971

1940	REPORT
10/23	Location
10/31	10" p 341' WOC.
11/7	Drlg. 3195'
11/14	Lansing ³⁶⁴⁷ 3647' 5" - ³⁸⁰⁵ 3799-3800' T.
	RUST.
11/21	Lans. 3647 3647' (Corrected)
	5" - 3805' Pay 3813-28' T.D.
	5000 acid. Pump 22 bbls. $\frac{1}{4}$ hr.
11/26	Lans. 3647'
	5" - 3805'
	T.D. 3828'
	5000 acid.
	Bomb potential 17,849 bbls.
	Maximum 3000 bbls.
	40.4 Gravity
	COMPLETED

Map No. 83 Sec. 16 Twp. 25 R. 14WWell No. 2 Nieland "B"

Cities Service Oil

Company

Contractor

COMPLETED

SECTION PLAT

990 SW NE SE
Ft. from N. Line

Ft. from S. Line

990 Ft. from E. Line

Ft. from W. Line

KIPP POOL

Location

RECORD

Cased in. ft.

Sand

Gas

Oil

Total Depth 3825

PRODUCTION

1st 24 hrs. Nat.

1st 24 hrs. after shot

Gas Cu. Ft.

Dry Hole

Abandoned

Rig up

Drilling and Remarks:

Lease 36475" @ 3825.5000 galsBorn & PT 17849Max 300040" br.

Date

NOV 26 1940 19

S. J. LEWIS Scout

Map No. 83 Sec. 16 Twp. 25 R. 14WWell No. 2 Nieland "B"

Cities Service Oil

Company

Contractor

FIRST REPORT

SECTION PLAT

990 SW NE SE
Ft. from N. Line

Ft. from S. Line

990 Ft. from E. Line

Ft. from W. Line

KIPP POOL

Location X

RECORD

Cased in. ft.

Sand

Gas

Oil

Total Depth

PRODUCTION

1st 24 hrs. Nat.

1st 24 hrs. after shot

Gas Cu. Ft.

Dry Hole

Abandoned

Rig up

Drilling and Remarks:

Date

OCT 23 1940 19

S. J. LEWIS Scout