


Section 16 Township 25 Range 14W

Well No. #3 Nieland "B"

Company Cities Service

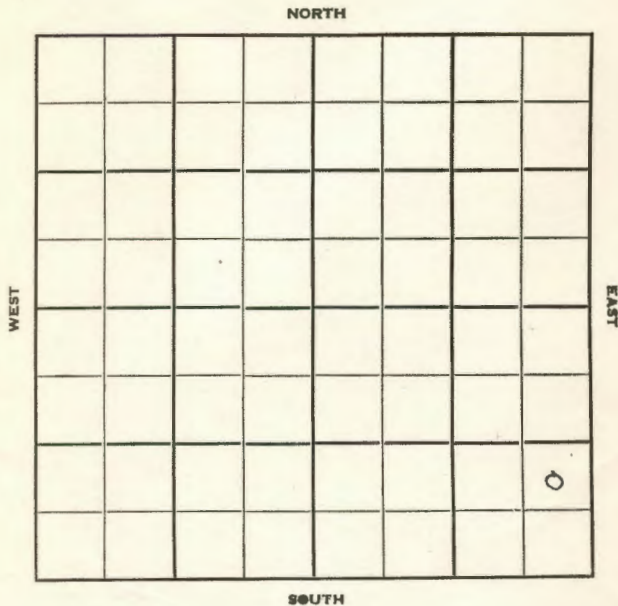

Sec. 16 Twp. 25 R. 14W

Well No. #3 Nieland "B" Farm _____

Cities Service Company _____

Jordan Pool Contractor _____


Ft. from N. Line

990 Ft. from S. Line

330 Ft. from E. Line

Ft. from W. Line

NE SE SE

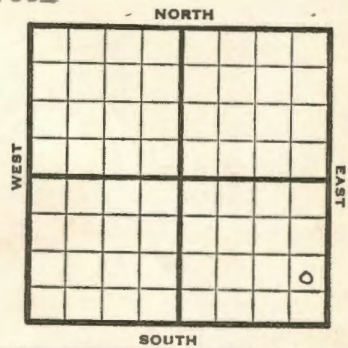

1952 **Elev. 1970'** REPORT

- 2/20 Location
- 3/5 **Br Li 3600 Lans. 3626**
DST 3704-17 1 hr. 425' oil 85' MC oil 960# 15" Taking DST
- 3/12 DST 3721-33 1 hr 85' m 1060#
DST 3846-51 1 hr. 130' oily m & 120 muddy oil 975# RTD 3890 5" @
- 3/19 5" @ 3889 CO to 3880
62/ 3852-67 24/ 3840-46 1500' oil 14 hrs. 2500 A 101 bopd & 5% wtr. & HOLD
- 3/24 (Did not complete)
Set pkr 3849' P/39 BO & 73 BW
Sq off 3840-46' CO 3880' SSO
- 4/1 59/3852-67 1000 A P/81 BO plus 15 BW, 24 hrs. 62/3806-23, 2000 A 3806-23' P/87 BO plus 57 BW from 2806-23'
- 4/9 PB 3800' 41/3772-82 48/3706-18 2200 oil 12 hrs. 2000 A P/229 BO & 12 BW 24 hrs.
- 4/23 CO 3879 P/40 BO & 2 BW 4 1/2 hrs.
- 4/30 NR
- 5/7 "
- 5/14 "
- 5/21 "
- 5/28 "

OVER

1952

6/11 Spud 2-22-52
Oil well TD 3890 8" @ 375-
Br Li 3600 Lans. 3626
DST 3704-17 open 1 hr. rec. 425'
oil 85' mco
DST 3721-33 open 1 hr. rec. 85' mud
DST 3846-51 open 1 hr. rec. 130'
oily mud 120' muddy oil TD 3890
5" @ 3889 CO to 3880' 62/ 3852-67
24/ 3840-46 FU 1500' oil 14 hr.
2500 A test 101 bopd 5% wtr.
SP 3849 P/ 39 bo 73 bw sq. off
3840-46 CO to 3880 SSO 59/ 3852-67
1000 A P/ 81 bo 15 bw 24 hr.
62/ 3806-23 2000 A P/ 87 bo
57 bw FB 3800 41/ 3772-82
48/ 3706-18 FU 2200' oil 12 hr.
2000 A P/ 229 bo 12 bw CO to 3879
P/ 40 bo 2 bw 4½ hr. Comp. 288 bopd

COMPLETED

Drig. Data

FU 2200+ oil 12 hr. 2000 A

P/ 229 bo 12 bw CO to 3879 P/ 40 bo

2 bw 4 $\frac{1}{2}$ hr. Comp. 288 bopd

JUN 18 1952

Scout Cards
Land Small Map
Land Wall Map
Tracings
Parce Map
Price Map
Misc.