


KANSAS

FORM 51 5M 4-41 PETROL

Stafford

Section 16 Township 25 Range 14-W
 Well No. #2 Neiland "A"
 Company Cities Service Oil et al

NORTH Jordan pool

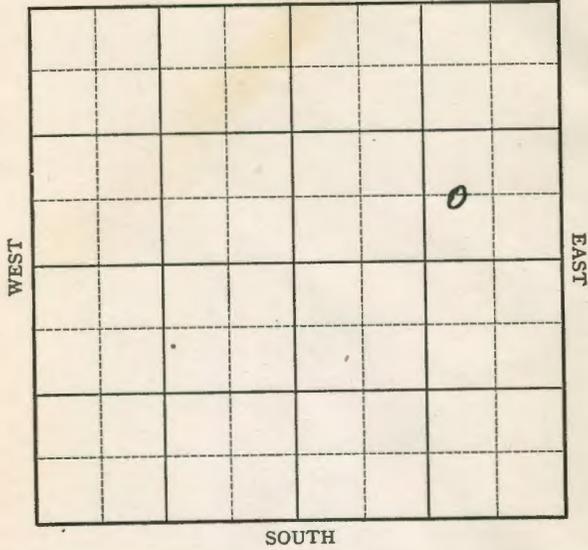


FORM 252-A 5M 1-41 PETROL

KANSAS

Stafford

Sec. 16 Twp. 25 R. 14-W
 Well No. #2 Neiland "A" Farm _____
Cities Service Oil et al Company _____
 (Jordan)

_____ Ft. from N. Line
660 Ft. from S. Line
990 Ft. from E. Line
~~525~~
 _____ Ft. from W. Line

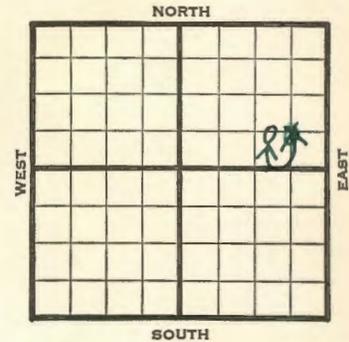

Elev. 1970

1941	REPORT
5/27	5" - 352' Drlg. 2226'
6/5	T.D. 2945' Lost hole. Skid rig. Drlg. 400'
6/12	10" - 403' Drlg. 2985'
6/19	Lans. 3645' 5" - 3808' T.D. 3810' RUST.
6/26	T.D. 3831' 5000 acid. Swab 3 bbls. per hour 24 hours.
7/3	T.D. 3901' 1500' water. P.B. to 3858' WOC.
7/10	P.B.
7/16	Lans. 3645' 5" - 3808' T.D. 3901' Water.
	ABANDONED

Map No. 83 Sec. 16 Twp. 25 R. 14W

Well No. 2 Neiland "A"

Cities Service Oil etal Company

ABANDONED Contractor

SECTION PLAT

C W L SE NE
_____ Ft. from N. Line
660 Ft. from S. Line
990 Ft. from E. Line
_____ Ft. from W. Line

			o

JORDAN POOL

Location _____
Rig up _____
Drilling and Remarks:

*Loss 3645.
5" @ 3508.
Water*

RECORD

Cased _____ in., _____ ft.
Sand _____
Gas _____
Oil _____
Total Depth 3901

PRODUCTION

1st 24 hrs. Nat. _____
1st 24 hrs. after shot _____
Gas _____ Cu. Ft.
Dry Hole _____
Abandoned _____

Date
JUL 16 1941 19

S. J. LEWIS Scout

Map No. _____ Sec. 16 Twp. 25 R. 14W

Well No. 2 Neiland "A"

Cities Service Oil etalCompany

FIRST REPORT Contractor

C W L S E N E

SECTION PLAT

			o

_____ Ft. from N. Line

660 Ft. from S. Line

330 Ft. from E. Line

_____ Ft. from W. Line

JORDAN POOL

Location _____

RECORD

Cased _____ in., _____ ft.
 Sand _____
 Gas _____
 Oil _____
 Total Depth _____

Rig up _____

Drilling and Remarks:

5"-352

Drlg. 2226

PRODUCTION

1st 24 hrs. Nat. _____
 1st 24 hrs. after shot _____
 Gas _____ Cu. Ft.
 Dry Hole _____
 Abandoned _____

Date

MAY 27 1941 19

S. J. LEWIS Scout

Map No. 83 Sec. 16 Twp. 25 R. 14W

Well No. 2 Neiland "A"

Cities Service Oil etalCompany

CORRECTION Contractor

C W L S E N E

SECTION PLAT

			o

_____ Ft. from N. Line

660 Ft. from S. Line

990 Ft. from E. Line

_____ Ft. from W. Line

JORDAN POOL

Location _____

RECORD

Cased _____ in., _____ ft.
 Sand _____
 Gas _____
 Oil _____
 Total Depth _____

Rig up _____

Drilling and Remarks:

Reported

660 x 330

PRODUCTION

1st 24 hrs. Nat. _____
 1st 24 hrs. after shot _____
 Gas _____ Cu. Ft.
 Dry Hole _____
 Abandoned _____

Date

MAY 27 1941 19

S. J. LEWIS Scout