


WELL RECORD

8-25-15W

(Mail to Kansas Geological Survey, 4150 Monroe Street, Wichita, Kansas 67209)

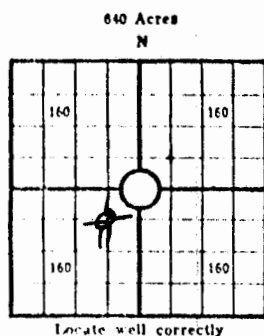

Lease Name: Cotton Well No. 2
 Well Located: Stafford County, Kansas
C NE SW SEC 8 TWP 25S RGE 15W
 Operator: Leben & Associates
 Address: 200 West Douglas, Suite 300 Wichita, Ks.
 Elevation: Ground 2043 D.F. 2045 K.B. 2048
 Type Well: (Oil, gas, dry hole) Dry

Drilling Commenced: Oct. 2 1971 Drilling Completed: Oct. 8 1971
 Well Completed: Oct. 8 1971 Total Depth 3985'
 Initial Production: _____

Casing Record

Size: 8 5/8" Set at 679' Size: _____ Set at _____
 Size: _____ Set at _____ Size: _____ Set at _____

Liner Record

Size: _____ Set from _____ To _____

Cementing

<u>Casing Size</u>	<u>Sacks</u>	<u>Type Cement and Additives</u>
<u>8 5/8"</u>	<u>400</u>	_____
_____	_____	_____
_____	_____	_____

Perforations

<u>Formation</u>	<u>Perforated Interval and Number Shots</u>
_____	_____
_____	_____
_____	_____
_____	_____

Electric Log Run (Show type log and depths covered)

Show Drill Stem Tests,
Well Stimulation and
Production Tests

8-25-15w

Formation	Top	Bottom	
Anhydrite	1052		DST #1 3155-3187, 30-30-30-30 Strong Blow
Elmont	1040		Rec. 870 ft. Water ISIP 1096 FSIP 1075# IFP 53# FFP 457#
Howard	1124		DST #2 3843-3900 30-30-30-30 Rair Blow
Topeka	1196		Increasing To Strong Recover 500 Ft
Heebner	1611		Muddy Gas Cut Water. IBHP 1294# FBHP 1272# IFP 60 FFP 276
Toronto	1630		DST #3 3940-3960 30-30-60-30 Weak blow
Brown Lm	1759		Recover 120 ft. Muddy Wtr. 245 ft
Lansing KC	1771		Water salt IBHP 1286# FBHP 1251# IFP 34# FFP 208#
Zone	1897		



Smp Tops

Anhy	996
B Anhy	1008
How	3172
Top	3244
Heeb	3659
Br Lm	3807
Lans	3819
Rtd	3984

0'	-	25'	sd & clay
25'	-	170'	sd & sh
170'	-	679'	sh & sd
679'	-	996'	red bed
996'	-	1008'	anhy
1008'	-	1400'	sh
1690'	-	2075'	sh & lm
2075'	-	3450'	lm & sh
3450'	-	3985'	lm