Stafford County


FORM 51 10M 8-47

KANSAS

Section 12 Township 25 Range 15W

Well No. 1 Grunder

Company Musgrove Pet.

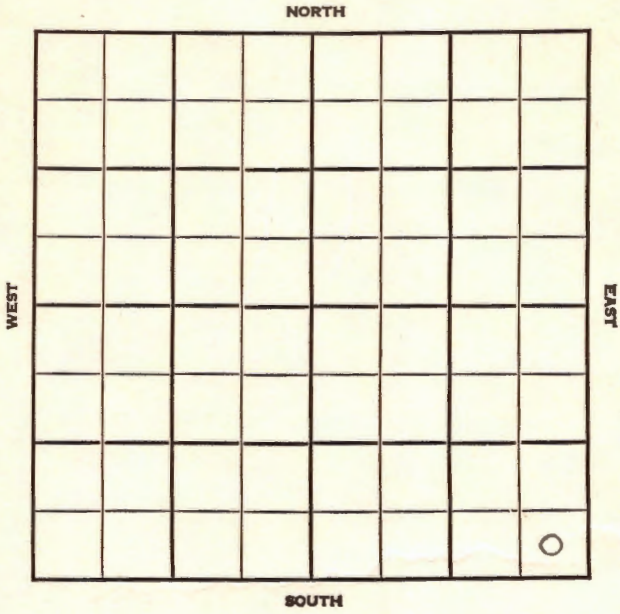

FORM 252-A
5M 9-47 PETROL

KANSAS Stafford ✓

Sec. 12 Twp. 25 R. 15W

Well No. #1 Grunder Farm

Musgrove Pet. Company

Wildcat


____ Ft. from N. Line

330 Ft. from S. Line

330 Ft. from E. Line

____ Ft. from W. Line

SE/C

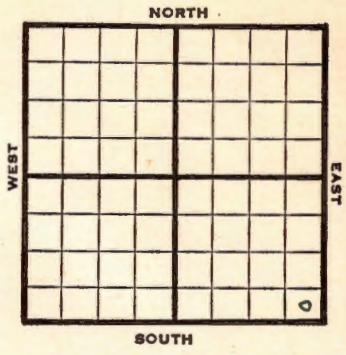

	REPORT
1947	Elev. 2019'
12/17	RUR
12/30	8" @ 245' Drlg. 2285'
1948 1/7	Lansing 3765' Drlg. 4125'
1/14	Lans. 3816' Miss. 4225' Arb. 4498' TD 4550' Abd.

ABANDONED

Form 26 200 Bks. 10-46 Petrol

Kansas

Wildcat

Map No. _____ Sec. 12 Twp. 25 R. 15W


Well No. 1 Grunder

Musgrove Pet. Company

FIRST REPORT Contractor

SE/C

SECTION PLAT

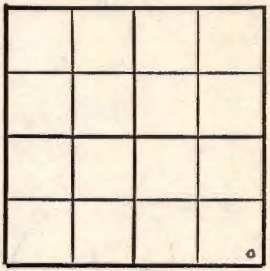

_____ Ft. from N. Line

330 Ft. from S. Line

330 Ft. from E. Line

_____ Ft. from W. Line

Stafford County

Location _____

Rig up _____

Drilling and Remarks:

R U R

RECORD

Cased _____ in., _____ ft.

Sand _____

Gas _____

Oil _____

Total Depth _____

PRODUCTION

1st 24 hrs. Nat. _____

1st 24 hrs. after shot _____

Gas _____ Cu. Ft.

Dry Hole _____

Abandoned _____

Date

DEC 17 1947 19

S. J. LEWIS Scout

Form 26 200 Blks. 10-46 Petrol

Wildcat

Kansas

Map No. K83 Sec. 12 Twp. 25 R. 15W

Well No. 1 Grunder


Musgrove Pet. Company

ABANDONED Contractor

SE/C

2-1-2019

SECTION PLAT

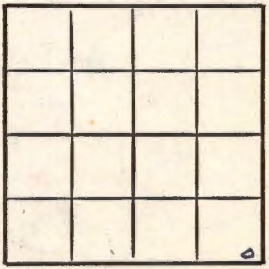

____ Ft. from N. Line

330 Ft. from S. Line

330 Ft. from E. Line

____ Ft. from W. Line

Stafford County

Location

Rig up

Drilling and Remarks:

Lans 3816
Miss 4225
RTD 4498

RECORD

Cased ____ in., ____ ft.

Sand

Gas

Oil

Total Depth 4550

PRODUCTION

1st 24 hrs. Nat.

1st 24 hrs. after shot

Gas ____ Cu. Ft.

Dry Hole

Abandoned

Date

JAN 14 1948 19

S. J. LEWIS Scout