FORM 51 10M 2-49 PETROL


Stafford KANSAS

Section 12 Township 25 Range 15W

Well No. #2 Grunder

Company Cities Service

Grunder Pool

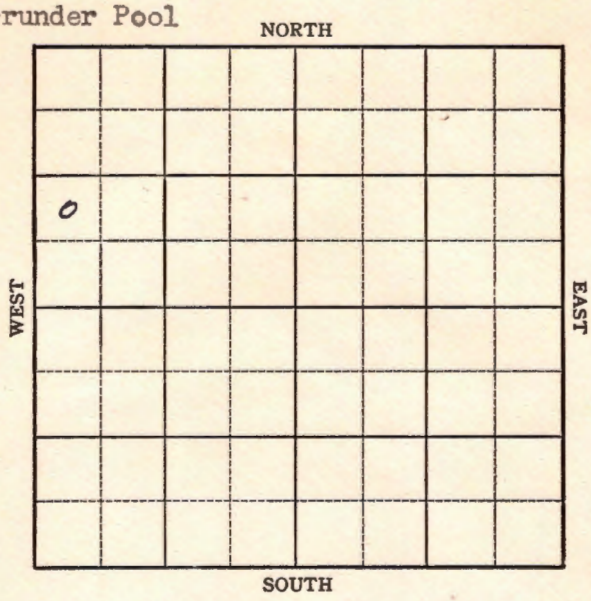

FORM 252-A
5M 10-48 PETROL


Stafford

Sec. 12 Twp. 25 R. 15W

Well No. #2 Grunder Farm

Cities Service Company

Grunder Pool

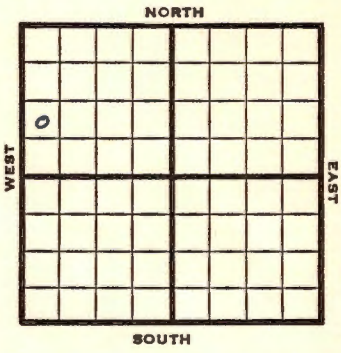

_____ Ft. from N. Line

990' Ft. from S. Line

_____ Ft. from E. Line

330' Ft. from W. Line

NW SW NW

1949	Elev 2022'	REPORT
12/14	Location	
12/21	8"@ 258'	
	Drlg 1290'	
12/28	"	
1950		
1/11	TD 4046'	
	8"@ 258'	
	Lans 3800'	
	DST3934-43'	
	DST 3965-77'	
	No shows.	
	D&A	
	Aband.	

ABANDONED

Form 26 200 Bks. 6-49 Petrol

Kansas

Grunder Pool

Map No. _____ Sec. 12 Twp. 2 S R. 15W

Well No. 2 Grunder


Cities Service Company

Contractor

NW SW NW

FIRST REPORT

SECTION PLAT

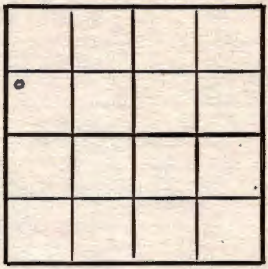

_____ Ft. from N. Line

990 Ft. from S. Line

_____ Ft. from E. Line

330 Ft. from W. Line

Stafford County

Location x

Rig up

Drilling and Remarks:

RECORD

Cased _____ in., _____ ft.

Sand

Gas

Oil

Total Depth

PRODUCTION

1st 24 hrs. Nat.

1st 24 hrs. after shot

Gas _____ Cu. Ft.

Dry Hole

Abandoned

Date

1

DEC 14 1949 19

S. J. LEWIS Scout

Form 26 200 Bks. 6-49 Petrol

Kansas

Grunder Pool

Map No. _____ Sec. 12 Twp. 25 R. 15W

Well No. 2 Grunder

Cities Service Company

Contractor

NW SW NW

Elev. 2022

SECTION PLAT



_____ Ft. from N. Line

990 Ft. from S. Line

_____ Ft. from E. Line

330 Ft. from W. Line

Stafford County

Location _____

Rig up _____

Drilling and Remarks:

8" @ 258
Lan 3800
D.S.T 3934-43
D.S.T 3965-77
no Shows
D & A

RECORD

Cased _____ in., _____ ft.

Sand _____

Gas _____

Oil _____

Total Depth 4046

PRODUCTION

1st 24 hrs. Nat. _____

1st 24 hrs. after shot _____

Gas _____ Cu. Ft.

Dry Hole _____

Abandoned _____

Date

JAN 11 1950 19

J. E. TYRA Scout