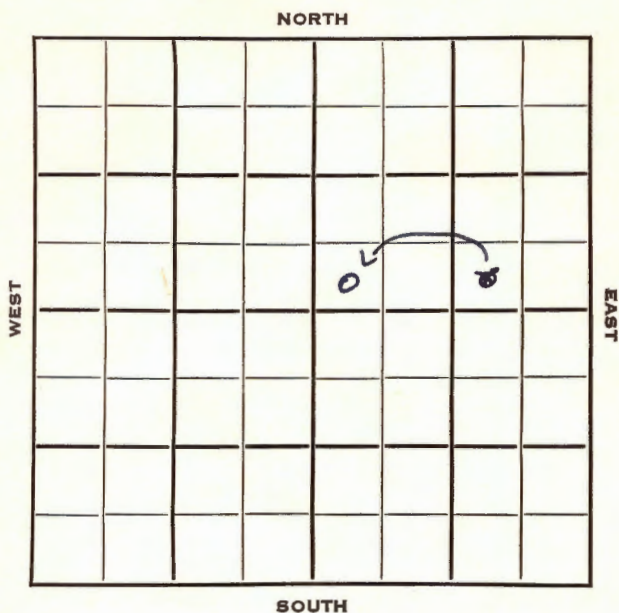


Section 13 Township 25 Range 15WWell No. 1 WilsonCompany Trans-Era Petr.

Stafford

KANSAS

SEC.	TWP.	R.
13	25	15 W

WELL NO.

1 Wilson

FARM

COMPANY

Trans-Era Pet.

CONTRACTOR


Trans-Era
Wildcat

Ft. from N. Line

330 Ft. from S. Line

~~990~~ Ft. from E. Line

330 Ft. from W. Line

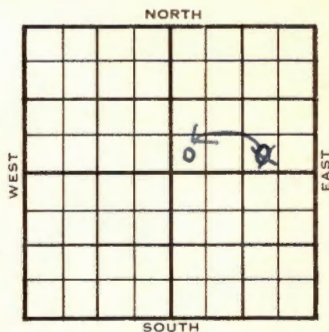SW ~~SE~~ NE
SW

1953

ELEVATION

2011'

REPORT

11/4

Spud 10-30-53

8" @ 157

11/11

Drlg. 1800'

Anhy 950', KC 3843'

Drlg 4260'

11/18

Spud 10-30-53 D & A TD 4640

8" @ 157 Anhy 950 KC 3843

Miss 4216 KH 4270 Viola 4314

DST 4317-23 open $\frac{1}{2}$ hr rec 7' mudDST 4315-23 open $\frac{1}{2}$ hr rec 5' mud

2025#


DST 4316-35 open 1 hr rec 61' mud

Simp. 4537' Arb. 4585'

TD 4640' D & A

ABANDONED

County Stafford State Kansas
 Sec. 13 (Blk.) 25 (Sur.) 1 5W Map No.
 Operator Trans-Era Pet.
 Well No. 1 Farm Wilson
 Elev. 2011 Location SW SW NE

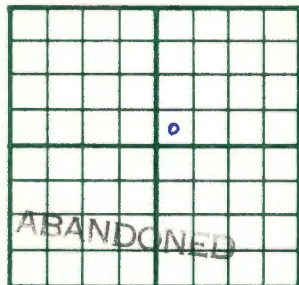

330 Ft. From S Line NE
330 Ft. From W Line Quarter

1st. Report

Completion NOV 18 1953

Remarks Wildcat

Trans-Era - Contr.

Spudding Date 10-30-53

Drilg. Data D & A TD 4640
8" @ 157 Anhy 950 KC 3843 Miss. 4216
KH. 4270 Viola 4314 DST 4317-23
open $\frac{1}{2}$ hr. Rec. 7' mud DST 4315-23
open $\frac{1}{2}$ hr. Rec. 5' mud 2025#
DST 4316-35 open 1 hr. Rec. 61' mud
Simp. 4537 Arb. 4585 TD 4640

D & A

J. G. McGEHEE

Map No. _____ Sec. 13 Twp. 25 R. 15WWell No. 1 Wilson

Trans-Era _____

Company _____

CORRECTION

Contractor _____

SW SW NE

SECTION PLAT

_____ Ft. from N. Line

330 Ft. from S. Line

_____ Ft. from E. Line

330 Ft. from W. Line

		o	

Stafford County

Location _____

Rig up _____

Drilling and Remarks:

Reported

SW SE NE

RECORD

Cased _____ in., _____ ft.

Sand _____

Gas _____

Oil _____

Total Depth _____

PRODUCTION

1st 24 hrs. Nat. _____

1st 24 hrs. after shot _____

Gas _____ Cu. Ft.

Dry Hole _____

Abandoned _____

Date

NOV 1 1952 19 J. G. McGEHEE Scout

FOR SALE BY KANSAS BLUE PRINT CO.

Stafford

State

Kanser

County

13

(Blk.)
(Twp.)

25

(Sur.)
(Rae.)

15 W

Map No.

Trans-Era Pet.

2

Farm

Wilson

Elev.

Location

SW SE NE

0

FIRST REPORT

330

Ft. From

S Line

III

990

Ft. From

R Line

Quarter

1st. Report

NOV

4

1953

Completion

Remarks

Trans-Era

- Contr.

Spudding Date

10-30-58

Drig. Data

Wildcat

80

167

dr1

1800