

KANSAS


Staffford

FORM 51 5M PETROL

Section 15 Township 25 Range 15-W

Well No. #1 Hart

Company Olson Drlg

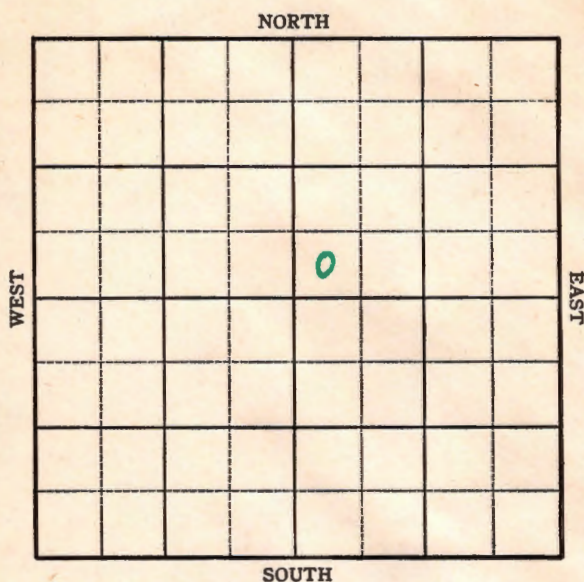

KANSAS

Stafford County

Sec. 15 Twp. 25 R. 15W

Well No. #1 Hart Farm

Olson Drlg. Company


Wildcat

 Ft. from N. Line

330 Ft. from S. Line

 Ft. from E. Line

330 Ft. from W. Line

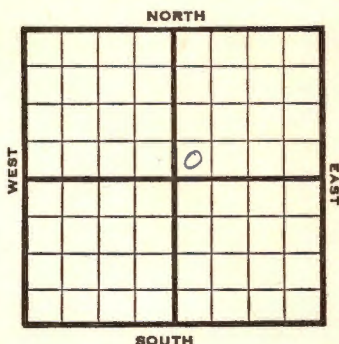

SW NE

REPORT

1945 Elev. 2025

12/19 RUR

12/29 10" - 306' Anhy 965'
Drlg. 2515'

1946

1/10 Lans. 3795'?? Drlg. 4179'

1/16

Lans 3799
BKC. 4112
Cong 4194
Viola 4326
Simp. 4407
Arb. 4498
TD 4538'

ABANDONED

Kansas Pool Name Wildcat**KANSAS**Map No. 14-83 Sec. 15 Twp. 25 R. 15WWell No. 1 HartOlson Drlg.


Company

FIRST REPORT

Contractor

SW NE

SECTION PLAT

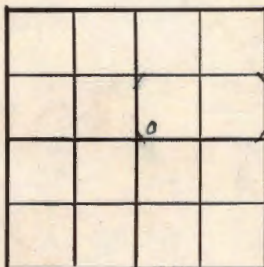 Ft. from N. Line330 Ft. from S. Line Ft. from E. Line330 Ft. from W. LineStafford CountyLocation Rig up

Drilling and Remarks:

RUR

RECORD

Cased in., ft.Sand Gas Oil Total Depth

PRODUCTION

1st 24 hrs. Nat. 1st 24 hrs. after shot Gas Cu. Ft.Dry Hole Abandoned

Date

DEC 1 9 1945

19

S. J. LEWIS

Scout

KANSAS

Kansas

Pool Name WildcatMap No. 83 Sec. 15 Twp. 25 R. 15WWell No. 1 HartOlson Drlg.

Company

ABANDONED

Contractor

SW NE

E. 1. 2025
SECTION PLAT

Ft. from N. Line

330 Ft. from S. Line

Ft. from E. Line

330 Ft. from W. Line

Stafford County

Location

Rig up

Drilling and Remarks:

Line 3789
DKC 4112
Cong 4154
Vista 4026
Bing 4407
AT 4498

RECORD

Cased _____ in., _____ ft.

Sand _____

Gas _____

Oil _____

Total Depth 4538

PRODUCTION

1st 24 hrs. Nat. _____

1st 24 hrs. after shot _____

Gas _____ Cu. Ft.

Dry Hole _____

Abandoned _____

Date

JAN 16 1946 19

S. J. LEWIS Scout