

KANSAS


Stafford

FORM 51 5M 11-44 PETROL

Section 2 Township 25 Range 15-N

Well No. #1 Daniel

Company Skelly

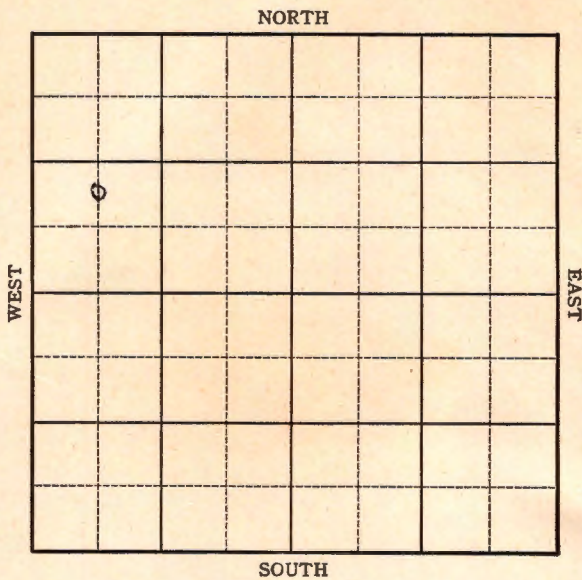

Sec. 2 Twp. 25 R. 15-W

Well No. #1 Daniel Farm


Skelly Company

 Ft. from N. Line

990 Ft. from S. Line

 Ft. from E. Line

660 Ft. from W. Line

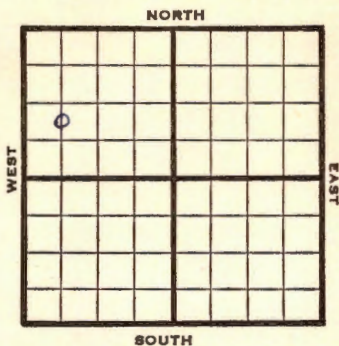

C N L SW NW

1945 **Elev. 2019'** REPORT

12/5 Location

12/12 RUR

12/20 8" - 958' Drlg. 2450'

12/29 Drlg. 3980'

1946

1/9 **Viola 4259**
Simp Sd. 4382
Arb. 4453
TD 4460'

ABANDONED

KANSAS Kansas Pool Name McGandless

Map No. 5-83 Sec. 2 Twp. 25 R. 15W

Well No. 1 Daniel

Skelly Company

FIRST REPORT Contractor

C N L SW NW


SECTION PLAT

 Ft. from N. Line

990 Ft. from S. Line

 Ft. from E. Line

660 Ft. from W. Line

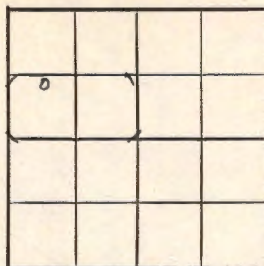

Stafford County

Location X

Rig up

Drilling and Remarks:

RECORD

Cased in., ft.

Sand

Gas

Oil

Total Depth

PRODUCTION

1st 24 hrs. Nat.

1st 24 hrs. after shot

Gas Cu. Ft.

Dry Hole

Abandoned

Date

DEC 5 1945 19 S. J. LEWIS Scout

KANSASPool Name McCandlessMap No. 83 Sec. 2 Twp. 25 R. 15WWell No. 1 DanielSkelly

Company

ABANDONED

Contractor

C N L SW NWE 1209
SECTION PLAT Ft. from N. Line990 Ft. from S. Line Ft. from E. Line660 Ft. from W. Line

0			

Stafford CountyLocation Rig up

Drilling and Remarks:

Vidla 4259Singlet 4382Art 4453

RECORD

Cased in., ft.Sand Gas Oil Total Depth 4460

PRODUCTION

1st 24 hrs. Nat. 1st 24 hrs. after shot Gas Cu. Ft.Dry Hole Abandoned

Date

JAN 9194619S. J. LEWIS

Scout