

KANSAS


Stafford

FORM 51 5M 1-42 PETROL

Section 2 Township 25 Range 15-W

Well No. #1 Greenwood "B"

Company Cities Service Oil

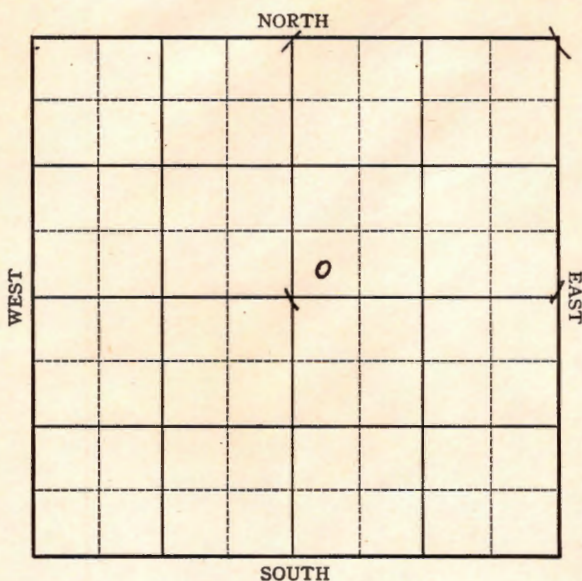

KANSAS

Stafford

Sec. 2 Twp. 25 R. 15-W

Well No. #1 Greenwood "B" Farm

Cities Service Oil Company


Wildcat

 Ft. from N. Line

330 Ft. from S. Line

 Ft. from E. Line

330 Ft. from W. Line

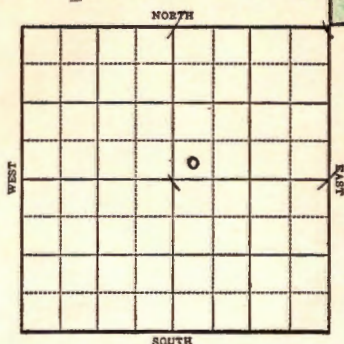

1943

Elev. 2017

R E P O R T

7/21 Location
7/28 "
8/4 Rotary.
8/11 10" @ 238'
Drlg. 1300'
8/18 Drlg. 3200'
8/25 **Topeka 3134**
Lans 3781
Drlg. 4090'
9/1 **Viola 4235**
Arb. 4442 $\frac{1}{2}$
T.D. 4455'
9/8 **Viola 4235**
Arb 444 $\frac{1}{2}$
T.D. 4485

ABANDONED

KANSAS

Map No. _____ Sec. 2 Twp. 25 R. 15W

Well No. 1 Greenwood "B"

Cities Service Oil Company

FIRST REPORT

Contractor _____

SW NE


_____ Ft. from N. Line

330 Ft. from S. Line

_____ Ft. from E. Line

330 Ft. from W. Line

SECTION PLAT

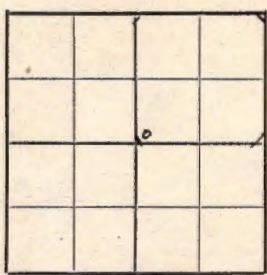

WILD CAT

Location X

Rig up _____

Drilling and Remarks:

RECORD

Cased _____ in., _____ ft.

Sand _____

Gas _____

Oil _____

Total Depth _____

PRODUCTION

1st 24 hrs. Nat. _____

1st 24 hrs. after shot _____

Gas _____ Cu. Ft.

Dry Hole _____

Abandoned _____

Date

JUL 21 1943

S. J. LEWIS

Scout

KANSASMap No. 83 Sec. 2 Twp. 25 R. 15WWell No. 1 Greenwood "B"

Cities Service Oil

Company

ABANDONED


Contractor

SW NE

SECTION PLAT

 Ft. from N. Line330 Ft. from S. Line Ft. from E. Line330 Ft. from W. Line

Wildcat

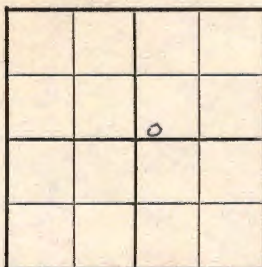Location Rig up

Drilling and Remarks:

*Wota 4230**Ce 8 44 42 1/2*

RECORD

Cased in., ft.Sand Gas Oil Total Depth 4485

PRODUCTION

1st 24 hrs. Nat. 1st 24 hrs. after shot Gas Cu. Ft.Dry Hole Abandoned

Date

SEP 8 1943 19

S. J. LEWIS Scout