

KANSAS


FORM 51 5M 1-42 PETROL

Stafford

Section 3 Township 25 Range 15-W

Well No. #1 Cora Smith

Company Sinclair-Prairie

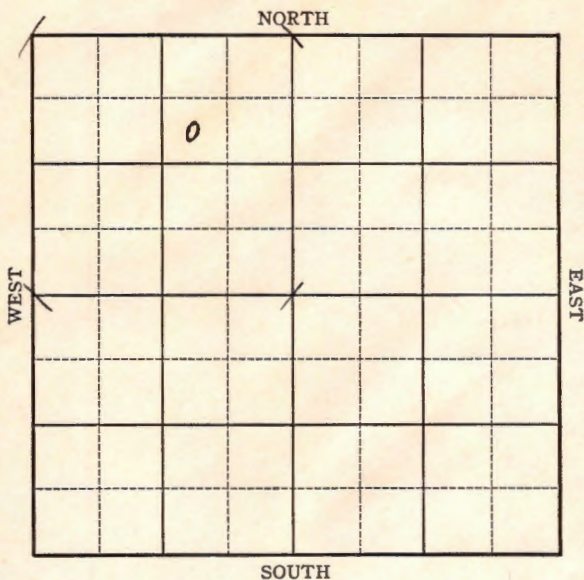

KANSAS

Stafford

Sec. 3 Twp. 25 R. 15-W

Well No. #1 Cora Smith Farm

Sinclair-Prairie Company


990 Ft. from N. Line

Ft. from S. Line

990 Ft. from E. Line

Ft. from W. Line

Farmington Pool

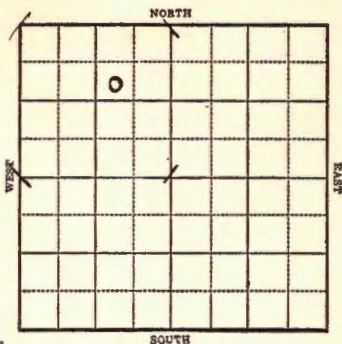

1943

elw-2033 R E P O R T

7/28

Derrick

8/4

Drlg. 190'

8/11

2045' Drlg.
10" @ 959

8/18

Drlg. 3550'

8/25

Drlg. 4327'

9/1

Lans 3780
Viola 4270
Aro 4455
T.D. 4495

ABANDONED


KANSAS

Stafford

Map No. 83 Sec. 3 Twp. 25 R. 15WWell No. 1 Cora SmithSinclair-Prairie CompanyFIRST REPORT Contractor

SW NE NW

SECTION PLAT

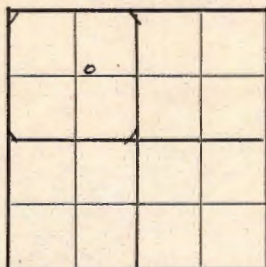990 Ft. from N. Line Ft. from S. Line990 Ft. from E. Line Ft. from W. LineFARMINGTON POOLLocation Rig up

Drilling and Remarks:

Derrick

RECORD

Cased in., ft.Sand Gas Oil Total Depth

PRODUCTION

1st 24 hrs. Nat. 1st 24 hrs. after shot Gas Cu. Ft.Dry Hole Abandoned

Date

JUL 28 1943 19 S. J. LEWIS Scout

KANSASMap No. 83 Sec. 3 Twp. 25 R. 15WWell No. 1 Core SmithSinclair-Prairie CompanyABANDONED Contractor

SW NE NW

SECTION PLAT

	6		

990 Ft. from N. Line

Ft. from S. Line

990 Ft. from E. Line

Ft. from W. Line

Farmington Pool

Location _____

Rig up _____

Drilling and Remarks:

Lane 3780
Viola 4270
BeX 4455

RECORD

Cased _____ in., _____ ft.

Sand _____

Gas _____

Oil _____

Total Depth 4495

PRODUCTION

1st 24 hrs. Nat. _____

1st 24 hrs. after shot _____

Gas _____ Cu. Ft.

Dry Hole _____

Abandoned _____

Date

SEP 1 1943 19

S. J. LEWIS Scout