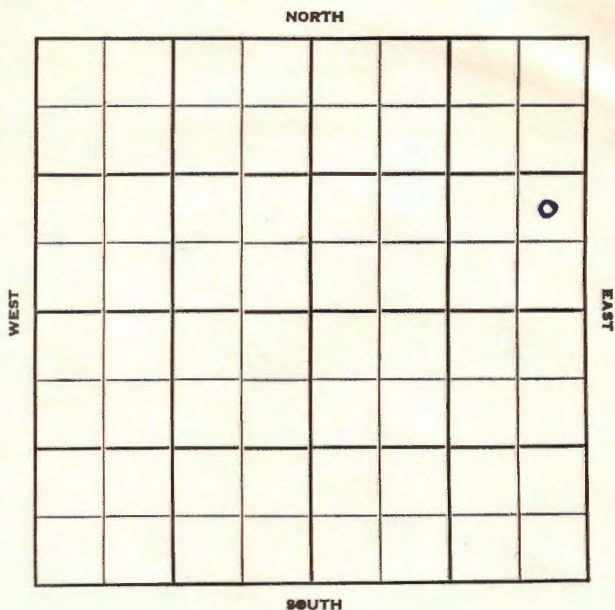


Stafford **KANSAS**Section 6 Township 25 Range 15 WWell No. # 1 WestgateCompany Cities Service Oil

Sec. 6 Twp. 25 R. 15WWell No. #1 Westgate FarmCities Service Oil Company

Contractor


Wildcat

Ft. from N. Line

990 Ft. from S. Line330 Ft. from E. Line

Ft. from W. Line

NE SE NE

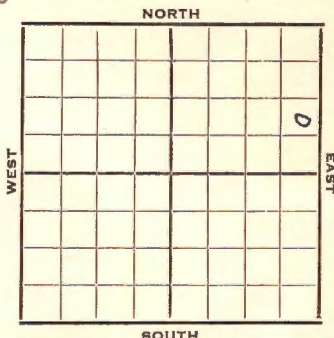

1952

Elev. 2051

REPORT

6/4

Drilling

6/11

8" @ 295' Topeka 3230

Heeb 3624

Dodge 3645

Douglas 3667

Br Li 3767

Lans. 3776

Drlg. 3880'

6/18

DST 3950-58, 1 hr, 10' M

DST 3950-68, 1 hr, 184' wtr.

Cherty cong. 4154' Meisner 4164'

DST 4170-4206, 1 hr,

4,260,000 gas V 4250'

Drlg. 4417'

6/25

Simp. dol. 4444 Simp sh 4452

f 4465-72 7' shale Arb 4520

RED 4570 5" @ 4280'

7/2

73/4166-84 68/4190-4207

4,606,000 gas

OVER

1952

7/9

Spud 5-31-52

Gas Well TD 4570

8" @ 295 Top 3230

Heeb. 3624 Dodge 3645

Doug 3667 Br lime 3767

Lans. 3776

DST 3950-58 opn 1 hr.

Rec. 10' mud 85# DST 3950-68

opn 1 hr. Rec. 184' wtr 1274#

Cong. 4154 Basal Penn 4164

DST 4170-4206 opn 1 hr. 4,260,000

gas 1320#

Viola 4250 Simp dol. 4444

Simp sh 4452

Cored 4465-72 Rec. 7' shale


Arb. 4520 TD 4570 5" @ 4280

73/ 4166-84 68/4190-4207

4,606,000 gas

Comp. 4,190,000 gas

COMPLETED

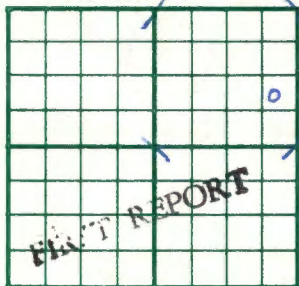County **Stafford** State **Kansas**Sec. **6** (Blk. Twp.) **25** (Sur. Rge.) **15W** Map No.Operator **Cities Service Oil**Well No. **1** Farm **Westgate**Elev. Location **NE SE NE**990 Ft. From **S** Line **NE**880 Ft. From **E** Line Quarter1st. Report **MIN 4 1952**


Completion

Remarks

Holm Drlg. - Contr.

Spudding Date

Drlg. Data **Wildcat****drlg.**

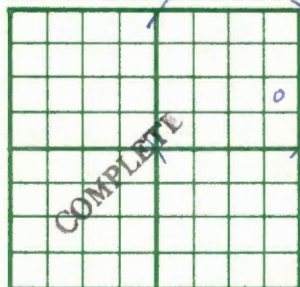County Stafford State KansasSec. 6 (Blk. Twp.) 25 (Sur. Rge.) 15W Map No.Operator Cities Service OilWell No. 1 Farm WestgateElev. 2051 Location NE SE NE990 Ft. From S Line NE330 Ft. From E Line Quarter

1st. Report

Completion ''' 9 1952Remarks WildcatHolm Drlg. - Contr.Spudding Date 5-31-52Drlg. Data Gas well TD 45708" @ 295 Top. 3230 Heeb. 3624Dodge 3645 Doug. 3667 Br. lime 3767Lans. 3776 DST 3950-58 open 1 hr.Rec. 10' mud 85# DST 3950-68open 1 hr. Rec. 184' water 1274#Cong. 4154 Basal Penn 4164 DST 4170-4206open 1 hr. 4,260,000 gas 1320#Viola 4250 Simp. dol. 4444 Simp. sh.4452 Cored 4465-72 Rec. 7' shaleArb. 4520 TD 4570 5" @ 4280 73/ 4166-84 68/ 4190-4207 4,606,000 gasComp. 4,190,000 gas

J. G. McGEHEE