

Section 5 Township 25 Range 15WWell No. #1 BarstowCompany Anschutz Drlg.

NORTH

WEST

EAST

				0			

SOUTH

Stafford

KANSAS ✓

Sec. 5 Twp. 25 R. 15W

Well No. #1 Barstow Farm

Anschutz Drlg. Company

Wildcat Contractor

Ft. from N. Line

330


Ft. from S. Line

Ft. from E. Line

330

Ft. from W. Line

SW SE NE

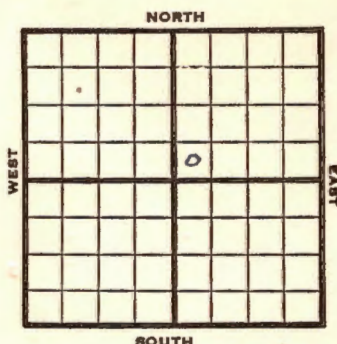

1952

Elev. 2072' REPORT

10/15

Spud 10-8-52

8" @ 328'

Anhy 1028

Drlg. 2530'

10/22

Heeb 3677' Br 11 3820' Lans. 3830'

DST 3842-72', 75 mins, 1960' gas,

110' O & GCM, 110' HO & GCM, 40'

muddy oil, 10' wtr. 630#

Drlg. 3900'

10/29

BKC 4103', Cong 4231

DST 4222-55, 1/2 hr., 5' M

KH 4285

DST 4269-97, 5 mins., 10' SOCM

V 4372', Simp sha 4498, Simp sd

4530

Drlg. 4560'

11/5

Arb 4573'

RTD 4593

5" @ 3908'

CO 3890', 70/3852-66, B/wtr +

SSO, 1000A S/4 BW + 2 qts oph

S/3 BW + SSOPH

OVER

1952

11/12 Spud 10-8-52

D&A

TD 4593

8" @ 328'

Anhy 1028, Heeb. 3677, Br. lime
3820, Lans 3830

DST 3842-72, opn 75 mins., rec.
1960' gas, 110' O&GCM, 110' ho
& gcm, 40' muddy oil, 10' wtr.
630#

B KC 4103, Cong. 4231

DST 4222-55, opn $\frac{1}{2}$ hr., rec.
5' mud

Kh. 4285,

DST 4267-97, opn 5 mins., rec.
10' socm

Viola 4372, Simp 4498, Simp sd
4530, Arb. 4573

TD 4593

5" @ 3908,


CO to 3890, 70/3852-66

B/wtr & SS0 1000A S/4 bw 2 qt
oil ph S/3 bw & sso ph

D&A

ABANDONED

County Stafford State Kansas
 Sec. 5 (Blk.) 25 (Sur.) 15W Map No.
 Operator Anschutz Drlg.
 Well No. 1 Farm Barstow
 Elev. 2072 Location SW SW NE

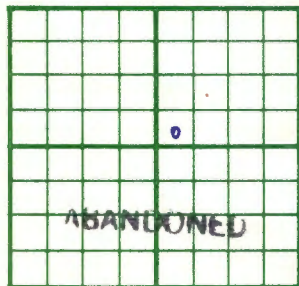

330 Ft. From S Line NE
330 Ft. From W Line Quarter
 Ist. Report
 Completion NOV 12 1950
 Remarks Wildcat
 Spudding Date 10-8-52

Drig. Data D & A TD 4593
8" @ 328 Anhy 1028 Heeb. 3677
Br. lime 3820 Lans. 3830 DST 3842-72
open 75 min. Rec. 1960' gas 110' 0 & gcm
110' ho & gcm 40' muddy oil 10' wtr.
630# B KC 4103 Cong. 4231 DST 4222-55
open $\frac{1}{2}$ hr. Rec. 5' mud Kh. 4285
DST 4267-97 open 5 min. Rec. 10' socm
Viola 4372 Simp. 4498 Simp. sd. 4530
Arb. 4573 TD 4593 5" @ 3908 CO to 3890
70/ 3852-66 B/ water & SSO 1000 A
S/ 4 bw 2 qt oil ph S/ 3 bw & SSO ph
D & A

J. G. McGEHEE