


Stafford

Section 11 Township 25 Range 15W

Well No. #1 Wilson

Company Wood River Corp.
Marylyn et al.

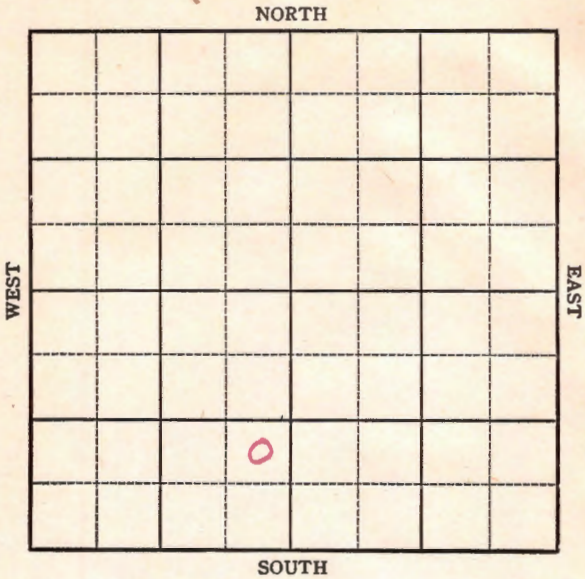

KANSAS

Stafford


Sec. 11 Twp. 25 R. 15W

Well No. #1 Wilson Farm

~~Marylyn et al~~ Wood River Corp. company

Wildcat

NORTH

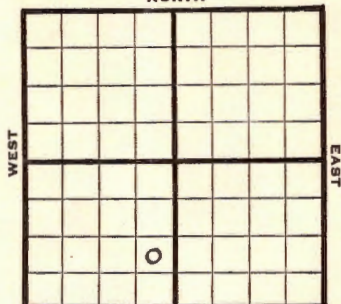

Ft. from N. Line

990 Ft. from S. Line

330 Ft. from E. Line

Ft. from W. Line

8/20/2011

1944

REPORT

5/3	Rotary
5/10	"
5/17	"
5/24	"
5/31	"
6/7	"
6/15	"
6/21	"
6/28	15" @ 20'
7/12	745 Drill pipe stuck
7/19	" " " "
7/26	10" @ 956 Drlg. 1450
8/2	Drlg. 3265
8/9	Lans 3774
	Drlg. 3811
8/16	" "
8/23	Simp Sd 4459
	Arb 4471
	TD 4500

ABANDONED

KANSAS

Pool Name WildcatMap No. 83 Sec. 11 Twp. 25 R. 15WWell No. 1 WilsonMarylyn etal.


Company

FIRST REPORT

Contractor

NE SE SW

SECTION PLAT

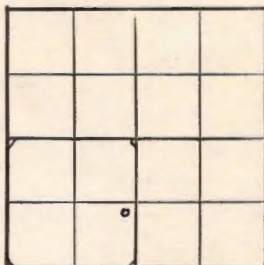

Ft. from N. Line

990

Ft. from S. Line

330

Ft. from E. Line

Ft. from W. Line

Stafford County

Location

Rig up

Drilling and Remarks:

Rotary

RECORD

Cased _____ in., _____ ft.

Sand _____

Gas _____

Oil _____

Total Depth _____

PRODUCTION

1st 24 hrs. Nat. _____

1st 24 hrs. after shot _____

Gas _____ Cu. Ft.

Dry Hole _____

Abandoned _____

Date

MAY 3 1944 19

S. J. LEWIS

Scout

Pool Name WildcatMap No. 82 **KANSAS** Sec. 11 Twp. 25 R. 15WWell No. 1 WilsonWood River Corp.


Company

CORRECTION

Contractor

NE SE SW

SECTION PLAT

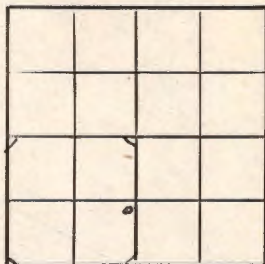 Ft. from N. Line990 Ft. from S. Line330 Ft. from E. Line Ft. from W. LineStafford CountyLocation Rig up

Drilling and Remarks:

Reported
Marylyn etal.

RECORD

Cased in., ft.Sand Gas Oil Total Depth

PRODUCTION

1st 24 hrs. Nat. 1st 24 hrs. after shot Gas Cu. Ft.Dry Hole Abandoned

Date

JUL 1 2 194419S. J. LEWIS Scout

Pool Name WildcatMap No. 83 Sec. 11 Twp. 25 R. 15WWell No. 1 WilsonWood River Corp.

Company

ABANDONED

Contractor

NE SE SW

SECTION PLAT

 Ft. from N. Line990 Ft. from S. Line330 Ft. from E. Line Ft. from W. LineStafford CountyLocation Rig up

Drilling and Remarks:

*Shut Sol 4459**Per 4471*

RECORD

Cased in., ft.Sand Gas Oil Total Depth 4500

PRODUCTION

1st 24 hrs. Nat. 1st 24 hrs. after shot Gas Cu. Ft.Dry Hole Abandoned

Date

AUG 23 1944 19S. J. LEWIS Scout