

KANSAS


FORM 51 5M 10-41 PETROL

Stafford

Section 11 Township 25 Range 15-W

Well No. #1 Barnerell

Company Cities Service Oil

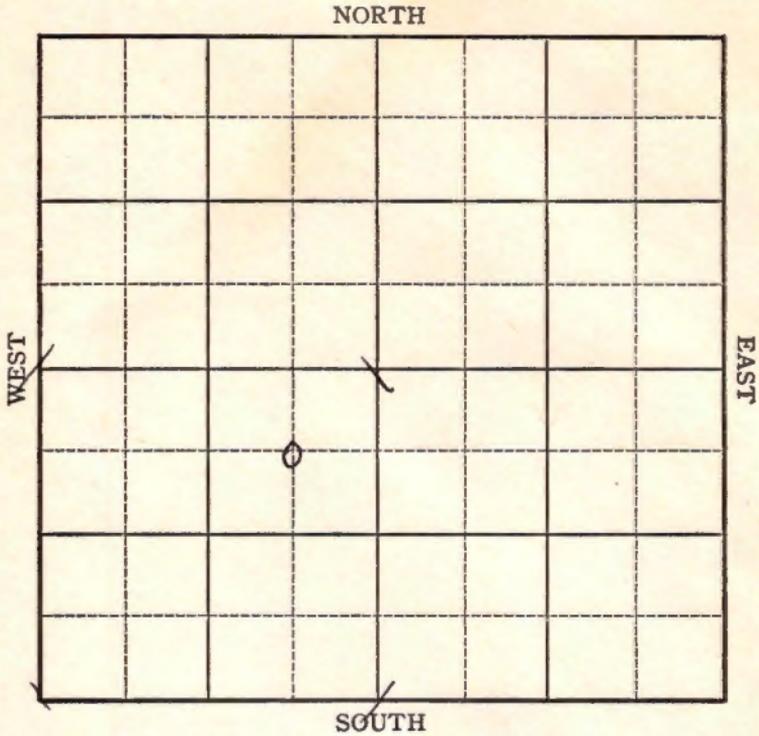

KANSAS

Stafford

Sec. 11 Twp. 25 R. 15-W

Well No. #1 Benerall Farm

Cities Service Oil Company

Wildcat

660 Ft. from N. Line


_____ Ft. from S. Line

660 Ft. from E. Line

_____ Ft. from W. Line

C NE SW

Elev. 2019

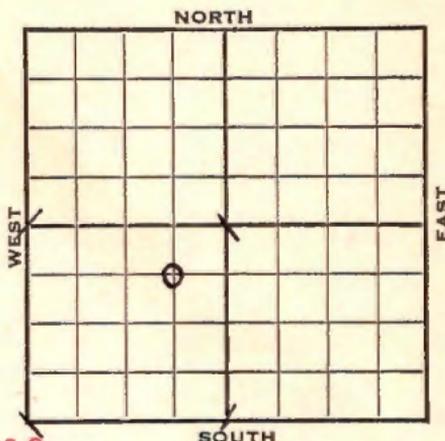

1943

REPORT

1/20 Location.

1/27 10" Casing set 205 WOC.

2/3 Drlg. 2125'

2/10 Drlg. 3485'

2/17 **Topeka 3132**

Lans 8767

SO 3793-3800-05, 3905-13

3931-40 TD

2/24 7" Casing set 3937 RUST.

Lans 3758

Drlg. 3978

So show

3/3 **BKC 4070**

TD 4085

PB 3992

3/10 4000 acid water PB

3/17 24 shots, 3749-23 $\frac{1}{2}$

Pump 16 fluid per hr 24 hrs 3% oil

OVER

1943

3/24

PB 3818-11 shots 3795-3806
12 shots 3806-10 $\frac{1}{2}$, 12 shots 3810 $\frac{1}{4}$ -15, 2000' water 18 hrs.

3/31

Lans 3758

7" @ 3952

Water

T.D. 4085'

ABANDONED

KANSAS

Map No. 23 Sec. 11 Twp. 25 R. 15W

Well No. 1 Bemerall

Cities Service Oil Company

Contractor

C NE SW


660 Ft. from N. Line

_____ Ft. from S. Line

660 Ft. from E. Line

_____ Ft. from W. Line

SECTION PLAT

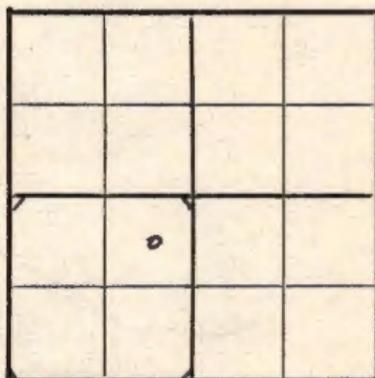

WILDCAT

Location XXX

Rig up _____

Drilling and Remarks:

RECORD

Cased _____ in., _____ ft.

Sand _____

Gas _____

Oil _____

Total Depth _____

PRODUCTION

1st 24 hrs. Nat. _____

1st 24 hrs. after shot _____

Gas _____ Cu. Ft.

Dry Hole _____

Abandoned _____

Date

JAN 20 1943 19

S. J. LEWIS Scout

KANSAS

Stafford

Map No. 83 Sec. 11 Twp. 25 R. 15W

Well No. 1 Bemere11

Cities Service Oil Company

ABANDONED Contractor

C NE SW

SECTION PLAT

660 Ft. from N. Line

_____ Ft. from S. Line

660 Ft. from E. Line

_____ Ft. from W. Line

	o		

WILDCAT

Location _____

Rig up _____

Drilling and Remarks:

*Loss 3258.
7" @ 3952
No log.*

RECORD

Cased _____ in., _____ ft.

Sand _____

Gas _____

Oil _____

Total Depth 4075

PRODUCTION

1st 24 hrs. Nat. _____

1st 24 hrs. after shot _____

Gas _____ Cu. Ft.

Dry Hole _____

Abandoned _____

Date

MAR 3 1 1943 19

S. J. LEWIS Scout