

Section 12 Township 25 S Range 16 W

Well No. #1 V. E. Miller

Company Skelly Oil Co.

NORTH

					0		

WEST

EAST

SOUTH

Edwards

KANSAS

SEC.	TWP.	R.
12	25S	16W

WELL NO. #1 V. E. Miller FARM

COMPANY Skelly Oil Co.

CONTRACTOR Wentworth


Wildcat

_____ Ft. from N. Line

_____ Ft. from S. Line

_____ Ft. from E. Line

_____ Ft. from W. Line

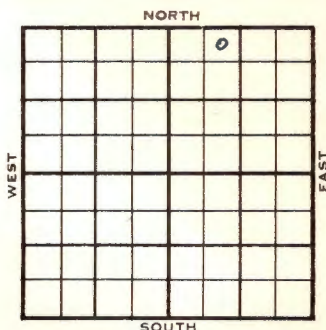

NE NW NE

Texas Co. DHM

1955	ELEVATION	REPORT
	2062'	

9/21

Location

11/9

Comm 9-19-55
8 5/8" @ 1021

Anh	1011	
H	3662	
BL	3802	
L	3816	3812
BKC		4080
Marm		4123
C	4192	4192
Penn B sd	4204	4200
Miss	4225	4226
K	4232	4232 4250
V	4304	4304
sh	4496	4502
sd	4518	4510
A	4579	4588
TD	4655	

DST 3836-72 open 1 hr rec 120' gcm
30' mw 500/20" DST 3946-62 open 1 hr
rec 55' mw 1358/20" DST 3978-4014
open 1 hr rec 95' mw 1355/20" DST
4196-4236 open 1 hr gas in 2 min
1,460 mcfg rec 30' gcm 1445#
DST 4480-4560 open 1 hr rec 35' mud
148# DST 4566-90 open 1 hr rec 20' mud

OVER

1955

11/9 1040# 5 $\frac{1}{2}$ " @ 4650 CO to 4643
94/4228-44 k 500 A 2,230 mcf
frac 1,930 mcf. 1000A 1,790 mcf
PB 4213 2/4211-12 gas to surface
immediately spray oil 38/4202-11
108 bo 500 A 2,860 mcf 24 hr

Comp open flow

COMPLETED

County **Edwards** Elev. _____
 Sec. **12** Twp. **25S** Rge. **16W**
 Company **Skelly Oil Co.**
 Farm Name **V. E. Miller** No. **1**

TOPS	DEPTH	LOG	DATUM
Anh.			
Tp.			
H.			
Tr.			
Dg.			
Bl.			
L.			
K.C.			
B.K.C.			
Ce.			
C.			
M.			
M.			
K.			
Mz.			
Ma.			
V.			
S.			
S.			
A.			
R.			
Pe.			
G.			
T.B.			

Loc. in Sec. _____
NE NW NE
~~**DS - NE/4**~~
Texas Co. - DHM
 Geol. _____
 Contr. _____
Wentworth
 Pool _____
Wildcat

		0
FIRST REPORT		

Date Comm. **Loc.** **SEP 21 1955**

[Handwritten signature and notes in red ink]

Co.
Lse.
No.
Sec.
T.
R.


County Edwards Elev. 2062
 Sec. 12 Twp. 25 Rge. 16W
 Company Skelly Oil
 Farm Name V. E. Miller No. 1

TOPS	DEPTH	LOG	DATUM
Anh.	<u>1011</u>		
Tr.			
H.	<u>3662</u>		<u>1600</u>
Dg.			
Bl.	<u>3802</u>		<u>1740</u>
L.	<u>3816</u>	<u>3812</u>	<u>1750</u>
K.C.			
B.K.C.		<u>4080</u>	<u>2018</u>
Ce.	<u>Marm</u>	<u>4123</u>	<u>2061</u>
C.	<u>4192</u>	<u>4192</u>	<u>2130</u>
M. <u>Perm. B. sd</u>	<u>4204</u>	<u>4200</u>	<u>2138</u>
M. <u>ss</u>	<u>4235</u>	<u>4226</u>	<u>2164</u>
K.	<u>4232</u>	<u>4250</u>	<u>2188</u>
Mz.			
Me.			
V.	<u>4304</u>	<u>4304</u>	<u>2242</u>
S. <u>sh</u>	<u>4496</u>	<u>4502</u>	<u>2440</u>
S. <u>sd</u>	<u>4518</u>	<u>4510</u>	<u>2448</u>
A.	<u>4579</u>	<u>4588</u>	<u>2526</u>
R.			
PE.			
G.			
T.D.	<u>4655</u>		

Loc. in Sec. NE NW NE

Geol. _____
 Contr. Wentworth

Pool Wildcat

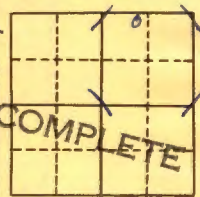

Date Comm. 9-19-55 NOV 9 1955
8 5/8" @ 1021 DST 3836-72 open 1 hr.
rec. 120' gcm 30' mw 500/20"
DST 3946-62 open 1 hr. rec. 55' mw
1358/20" DST 3978-4014 open 1 hr.
rec. 95' mw 1355/20" DST 4196-4236
open 1 hr. gas in 2 min. 1,460 mcf/g
rec. 30' gcm 1445# DST 4480-4560
open 1 hr. rec. 35' mud 1460#
DST 4566-90 open 1 hr. rec. 20' mud

OVER

Co.
 Loc.
 No.
 Sec.
 T.
 R.

1040# 5 1/2" @ 4650 CO to 4643
94/ 4228-44 500 A 2,230 mcfg
frac 1,930 mcfg 1000 A 1,790 mcfg
PB 4213 2/ 4211-12 gas to surface
immédiately spray oil 38/ 4202-11
108 bo 500 A 2,860 mcfg 24 hr.
Comp. open flow

_____	Misc.
_____	Pierce Map
_____	France Map
_____	Tracings
_____	Land Wall Map
_____	Land Small Map
_____	Scout Cards
<i>lll lll</i>	

NOV 18 1955