


Edwards

SECTION 23 TOWNSHIP 25S RANGE 16W #1

WELL NO. #2 Budde

COMPANY D.R. Lauck

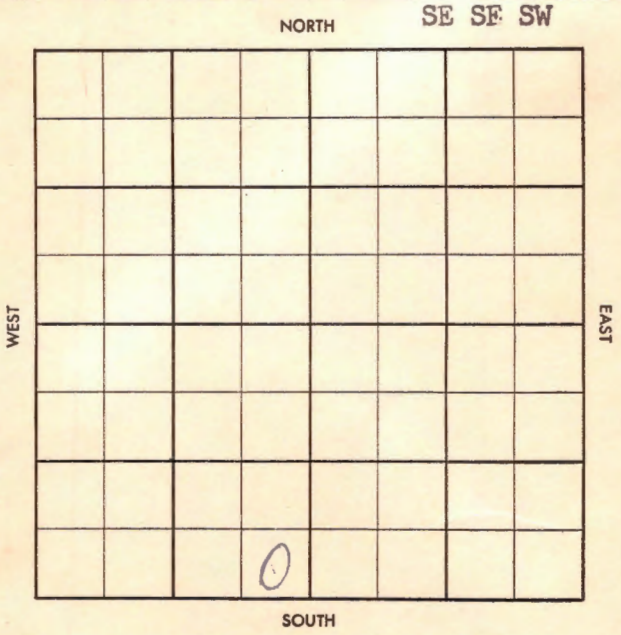

28

# WILDCAT

S-513-B

County Edwards Elev. \_\_\_\_\_  
 Sec. 23 Twp. 25 Rge. 16W  
 Company D. R. Lauck  
 Farm Name Budde No. 2

TOPS	DEPTH	LOG	DATUM
Anh.			
Tp.			
H.			
Tr.			
Dg.			
B.L.			
L.			
K.C.			
B.K.C.			
Ce.			
C.			
M.			
M.			
K.			
Mz.			
Mq.			
V.			
S.			
S.			
A.			
R.			
Pf.			
G.			
T.D.			

Loc. in Sec. \_\_\_\_\_  
SE SE SW  
 Geol. \_\_\_\_\_  
 Contr. \_\_\_\_\_  
D R Lauck #2  
 Pool \_\_\_\_\_  
Wildcat

*SDX* *offset*  
**FIRST REPORT**  
 JUN 29 1958

Date Comm. \_\_\_\_\_

**MIRT**

\_\_\_\_\_  
 \_\_\_\_\_  
 \_\_\_\_\_  
 \_\_\_\_\_  
 \_\_\_\_\_  
 \_\_\_\_\_  
 \_\_\_\_\_  
 \_\_\_\_\_

Twp. ~~X~~ Pool ~~X~~  
 Co. ~~X~~ Facet ~~X~~

5-513-B

County Edwards Elev. 2056 DF  
 Sec. 23 Twp. 25 Rge. 16W  
 Company D. R. Lauck  
 Name Budde No. 2

	DEPTH	LOG	DATUM
Tp.			
H.		3716	
Tr.		3736	
Dg.		3754	
B.L.		3858	
L.		3872	
K.C.			
B.K.C.		4160	
Ce.			
C. <u>sd</u>		4320	
M.			
M.			
K.		4422	
Mz.			
Mq.			
V.		4432	
S.			
S.			
A.			
R.			
Pf.			
G.			
T.D.	4443		

Loc. in Sec. SE SE SW  
 Geol. \_\_\_\_\_  
 Contr. D R Lauck #2  
 Pool Wil Extn NE  
Wildcat

COMPLETE  
*Offset*  
 APR 23 '58

Date Comm. 1-28-58 8" 345/250  
 MIRT FEB 5 '58 Ø 3690 FEB 12 '58 DST

4313-32 120" 9 1/6" ga 62 maff 12  
98 maff 120" rec 35' gem FP  
90-105 BHP 1440/30" DST  
4339-62 45" 9 1/2" ga 2060  
maff F10 spray oil 25" rec  
855' oil FP 1240-1420 BHP  
1500 DST 4416-43 60 39'M  
FP 100-80 BHP 300/30" Log top  
5 1/2 4443/125 "DST FEB 19 '58

Co.  
No.  
Sec.  
T.  
R.

24/4369-73 (1/2) \$2 Boph

NW 2 hrs Evac rec Ld Flo

60 Boph NW 3 hrs SI tanks

8 Flo 85 BO + 4% AW 15h

1 hr 55.7 gr 2nd hr Flo 72

BO + 20% AW 3rd hr 13/64" Flo

44 BO + 20% AW 4th Flo 6/64"

15 BO + 20% AW MAR 5 '58 Flo 13.8

Boph NW 6/64 ch MAR 12 '58

MAR 19 '58 MAR 26 '58 APR 2 '58 APR 9 '58 APR 16 '58 APR 23 '58

DOWN Flo 133780 NW pd

23-25-16W sea sw