


Edwards

KANSAS

SECTION 26 TOWNSHIP 25S RANGE 16W

WELL NO. #1 Will Russell

COMPANY Monsanto

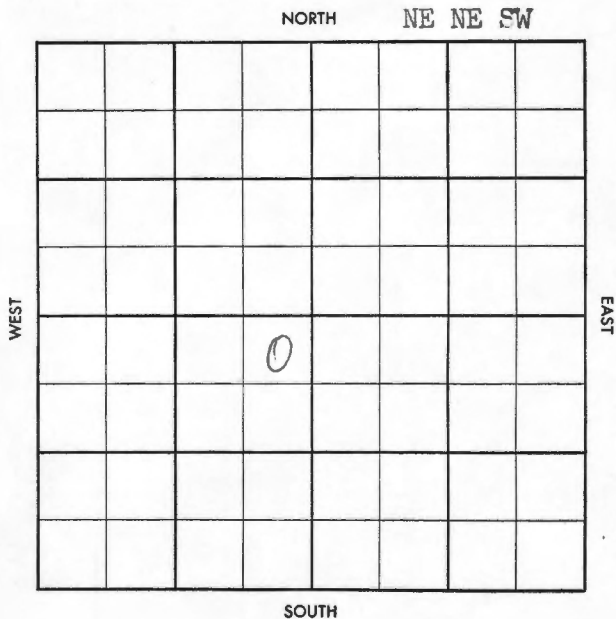

25

CO. Edwards ELEV. _____

SEC. 26 TWP. 25 RGE. 16W

COMPANY Monsanto NO. 1

| |
|--------------|
| DEC 1 1957 |
| FIRST REPORT |

FARM Will

SDX-Offset

LOC. NE NE SW

| | |
|--|--|
| | |
| | |
| | |
| | |
| | |
| | |
| | |
| | |
| | |
| | |

GEOLOGICAL _____

CONTR. D. R. Lauck tools

POOL Will

SPUD _____

MIRT

CO.

LSE.

NO.

SEC.

TWP.

RGE.