

O.W.W.O.


Edwards

KANSAS

SECTION 26 TOWNSHIP 25 RANGE 16 W

WELL NO. #1 Wilson

COMPANY L. C. Smitherman

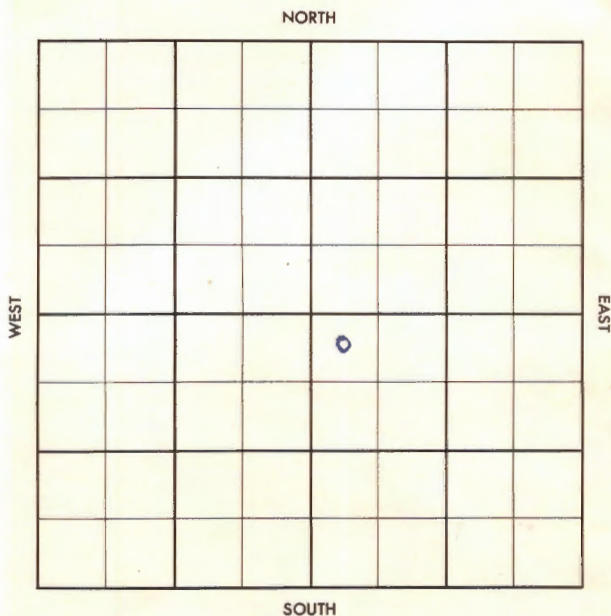

SEC.	TWP.	R.
26	25 S	16 W
WELL NO.		
# 1 Wilson		
FARM		
COMPANY		
L. C. Smitherman Drlg. Co.		
CONTRACTOR		


Wildcat

_____ Ft. from N. Line

_____ Ft. from S. Line

_____ Ft. from E. Line

_____ Ft. from W. Line

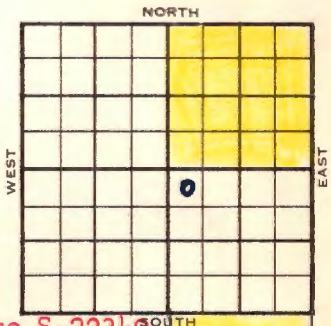

NW NW SE

Direct South Offset to Lse S-22340

SDX - DHC - \$3500.00 Lion - DHM

1956	ELEVATION	2057' DF	2059' RE	
3/14		2053.8 Gr.		(WH6-DC2)
4/18	Location	(FR Tkt)		
	Arbuckle Test appx 4700'			
	To be commenced by May 20, 1956			
	To be completed by July 1, 1956.			
5/8	Spd 5-6-56	8 5/8"		
	Set 400'	surface-pipe w/375 sks.		
	Drlg. 1195'	(Card-Smitherman Drlg)		
5/9	Drlg. 1978'	"		
5/10	Drlg. 2307'	"		
5/11	Drlg. 2575'	"		
5/12	Drlg. 2849'	"		
5/14	Drlg. 3320'	"		
5/15	Drlg. 3475'	"		
5/17	Heeb 3716'	Tor. 3733'	Doug 3751'	
	Drlg. 3858'	(Kansas Scout Ltr)		
5/31	DST 4310-70,	1 hr, rec 135'	VSO&GCM.	
	Received copy of Radiation Guard Log.			
	Given to S.A. Shannon, Div. Geolog.			
6/5	Commenced 5-6-56			
	Completed 5-25-56			
	TD 4735'. Plugged & Abandoned.			
	(See Comp. Letter-R.W.Mitchell, Dist. Landman, Wichita District)			
	Tops: H. 3716, Tr. 3733', Doug 3751',			
	BL 3853', L. 3867', BKC 4159', Marm 4200			
	K. 4324', V. 4377', S. 4617', A. 4700'			
	TD 4735'. D & A			
6/6	ABANDONED			
	Advised Contract Section - D & A			

O.W.W.O.

FORM 513 SURVEY

~~Edwards~~

Elev.

26

Temp. 25

Rgn. 16W

Company

L. C. Smitherman

Farm Name Wilson

No. 1

TOPS	DEPTH	LOG	DATUM	Loc. in Sec.
Anh.				NW NW SE
Tr.				
H.	3715			OWWO
Tr.	3733			
Dg.	3751			
BL.	3853			
L.	3967			
K.C.				Geol.
B.K.C.	4159			Contr.
Ce. Mdr	4200			
C.				
M.				
M.				Pool Wil
K.	4324			
Mz.				
Mq.				
V.	4377			
S.	4617			
S.				
A.				
R.				
PE.				
G.				
TD.	4735			

COMPLETE
NOV 6 '57

Date Comm.

OFFSET

OTD 4736 was D & A. (Old Info.)

(New Info.) 5" @ 4736 pt 1/4354-60 SO Frac. 250A

swb & Fl. Ld. Fl 200 BO + tr wtr, SLOW Tanks

DEPT 5" 2x3 Flw 360 BO + tr

B 5 Fl 20 BOPh now 24hrs

24^h CHK OCT 9 '57 F10

3 to 4 BOPh 1090w 1/2 CHK

OCT 16 '57 X OCT 23 '57 F10 about 10 BOPh

1.21w OCT 20 '57 F10 281 BOPh

+tr wa 36.9°K

J.W.W.O.

25

FORM 513 SUNRAY

County Edwards

Elev. _____

Sec. 26 Twp. 25Rgs. 16WCompany L. C. SmithermanFarm Name WilsonNo. 1

Co.

Loc.

No.

Sec.

T.

R.

TOPS

DEPTH

LOG

DATUM

Loc. in Sec.

Anh. _____ NW NW SE

Tp. _____

H. _____

Tr. _____

Dg. _____

Bl. _____

L. _____

K.C. _____

B.K.C. _____

Ce. _____

C. _____

M. _____

M. _____

K. _____

Mz. _____

Mo. _____

V. _____

S. _____

S. _____

A. _____

R. _____

P.E. _____

G. _____

ID. _____

Geol. _____

Contr. _____

Pool _____

SEP 18 '57

FIRST RETURN

Date Comm.

SDX - OFFSET

OTD 4736 was D & A. (Old Info.)

(New Info.) 5" @ 4736 pf 4354-60 SO Frac.

swb & Fl. Ld, Fl 200 BO + tr wtr, SIOW Tanks

2058 DF

2053 GF

County Edwards Elev. 2053 GF

Sec. 26 Twp. 25 Rge. 16W

Company L. C. Smitherman

Farm Name Wilson No. 1

TOPS	DEPTH	LOG	DATUM	Loc. in Sec.
Anh.				NW NW SE
TP.				
H.	3716			
Tr.	3733			
Dg.	3751			
BL.	3853			
L.	3867		1814	Geol.
K.C.				Cantr.
B.K.C.	4159		2106	
Ce. <i>Marm.</i>	4200		2147	
C.				
M.				
M.				Pool
K.	4324		2271	Wildcat
Mz.				
Mq.				
V.	4377		2324	
S.	4617		2564	
S.				
A.	4700		2647	
R.				
Pe.				
G.				
TD.	4735			

MAY 29 1956

Date Comm. 5-6-568 5/8" @ 400/375 DST 4310-70

open 1 hr. rec. 135' vso & gcm 1170#

D & A

County

~~Edwards~~

Elev.

Sec.

~~26~~

Twp.

~~25~~

Rge.

~~16W~~

Company

~~L. C. Smitherman~~

Farm Name

~~Wilson~~

No.

~~1~~

Co.

Lse.

No.

Sec.

T.

R.

TOPS

DEPTH

LOG

DATUM

Loc. in Sec.

~~NW NW SE~~

Anh.

Tp.

H.

Tr.

Dg.

Bl.

L.

K.C.

B.K.C.

Ce.

C.

M.

M.

K.

Mz.

Mq.

V.

S.

S.

A.

R.

Pe.

G.

Geol.

Contr.

Pool

~~Wildcat~~

T.D.

Date Comm.

Sunray Mid-Continent & Lion DENLocation