


Edwards

KANSAS

SECTION 35 TOWNSHIP 25S RANGE 16W

WELL NO. #1 Mahew

COMPANY L.C. Smitherman

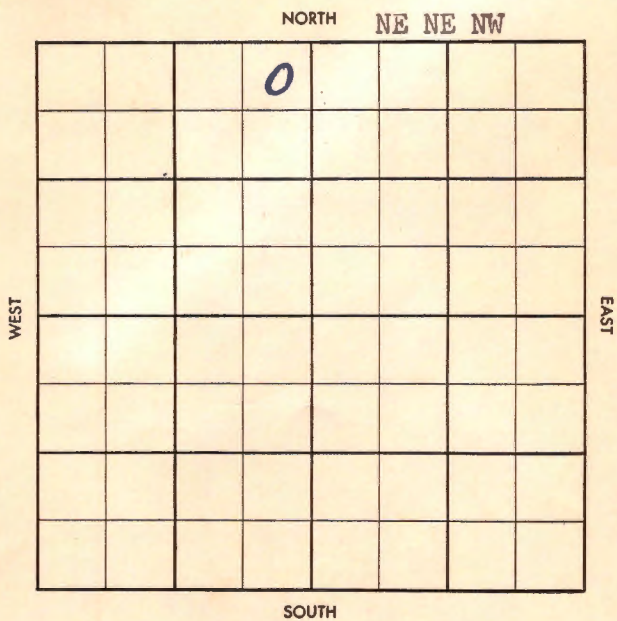

Twp. ~~X~~ Pool ~~X~~
 Co. ~~X~~ Facet ~~X~~

6-513-B

County Edwards Elev. 20500
 Sec. 35 Twp. 25 Rge. 16W 20618E
 L. L. Smitherman
 Name No. 1

TOPS	DEPTH	LOG	DATUM
Anh.	1045		
Tr.	3723		1662
H.	3741		1680
Dg.	3763		1702
B.L.	3862		1801
L.	3880		-1819
K.C.	4136		2075
B.K.C.	4328		-2367
Co. 5A	4338		-2277
CR 26	4364		-2303
C			
M.			
K. 5A	4381		-2338
KSD	4399		
Mq.			
V.			
S.			
A.			
R.			
Pf.			
G.			
T.D.	440		

Loc. in Sec. NE NE NW
 Geol. X
 Contr. Lauck #1
 Pool Wil

APR 2 '58
~~Offset~~
 COMPLETE

Date Comm. 1/25/58
 8" @ 390 w/275, Drlg. 1646 FEB 5 '58 04055
 FEB 12 '58 DST 4320 - 71 55" sp 6"
 ga 350 muf / 30" spray oil 140"
 rec 150' 14069cm FP 2357 400
 BHP 1420 - 1390 no log 5 1/2"
 4410/125 MICT FEB 19 '58 24/4368
 -74 (1/4) frac Flo Ld + Flo SUBOPH
 + 4490 w 840s MAR 19 '58 40 POT
 MAR 19 '58 MAR 26 '58 APR 2 '58
 Phu 10373 DODD NW 1/4 ckt

Co. No. Sec. T. R.

25

S-513-B

County Edwards Elev. _____
 Sec. 35 Twp. 25 Rge. 16W
 Company L. C. Smitherman
 Farm Name Maheew No. 1

TOPS	DEPTH	LOG	DATUM
Anh.			
Tp.			
H.			
Tr.			
Dg.			
B.L.			
L.			
K.C.			
B.K.C.			
Ce.			
C.			
M.			
M.			
K.			
Mz.			
Mq.			
V.			
S.			
S.			
A.			
R.			
Pf.			
G.			
T.D.			

Loc. in Sec. _____
NE NE NW
 Geol. _____
 Contr. _____
Lauck #1
 Pool _____
Wil

JAN 29 1958
FIRST REPORT
SDX-effect

Date Comm. 1/25/58
8" @ 390 w/275, Drlg. 1646

Co.
Lse.
No.
Sec.
T.
R.