


Section 1 Township 25 Range 17 WWell No. # 1 JohnsonCompany D. R. Lauck

Edwards KANSAS

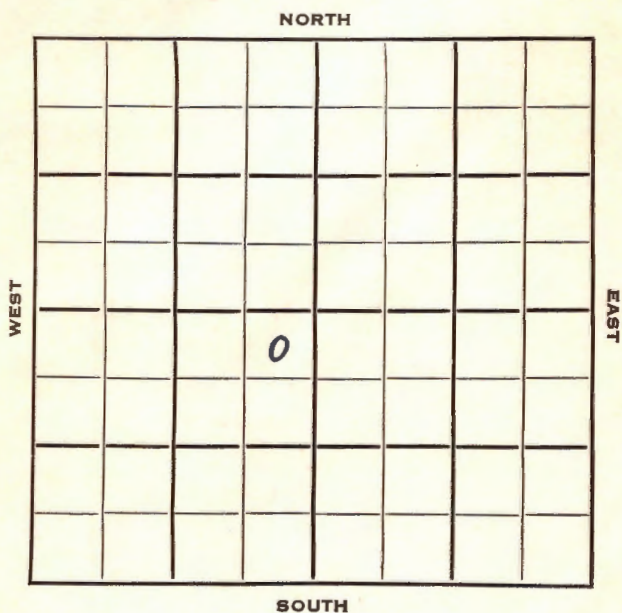

Sec. 1 Twp. 25 R. 17 W

Well No. # 1 Johnson Farm

D. R. Lauck Company

Contractor


Wildcat

330 Ft. from N. Line

Ft. from S. Line

330 Ft. from E. Line

Ft. from W. Line

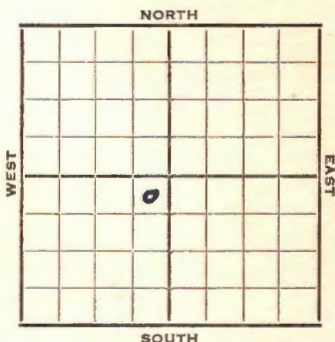

NE NE SW

Amerada DHM

1952 Elev. 2106' REPORT


11/26 Spud 11-21-52
8" @ 254
Drlg. 1545'

12/4 Drlg. 3730'

12/11 Anhy 1170 Br 1 3905 Lans 2916 Cong 3405
V 4543 Ø4660


12/17 Spud 11-21-52
D&A
TD4825
8" @ 254
Anhy 1170, Br lime 3905, Lans
3916, Cong 4401, Viola 4543,
Simp. 4712, Arb. 4772,
TD 4825
D&A

ABANDONED

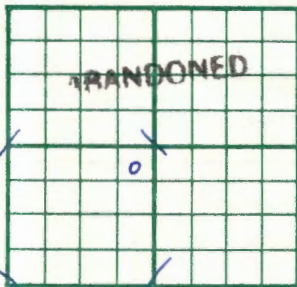County Edwards State KansasSec. 1 (Blk.
Twp.) 25 (Sur.
Rge.) 17W Map No.Operator D. R. LauckWell No. 1 Farm JohnsonElev. 2106 Location NE NE SW330 Ft. From N Line SW330 Ft. From E Line Quarter1st. ReportCompletion DEC 17 1952Remarks WildcatSpudding Date 11-21-52Drlg. Data D & A TD 48258" @ 254 Anhy 1170 Br. lime 3905Lans. 3916 Cong. 4401 Viola 4543Simp. 4712 Arb. 4772 TD 4825D & A

J. G. McGEHEE

County **Edwards** State **Kansas**
 Sec. **1** (Blk.) **25** (Sur.) **17W** Map No.
 Operator **D. R. Lauck**
 Well No. **1** Farm **Johnson**
 Elev. Location **NE NE SW**

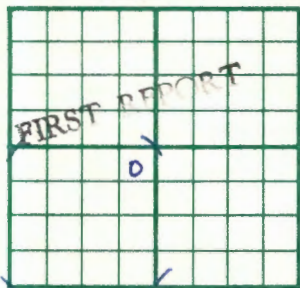

350 Ft. From **N** Line **SW**
350 Ft. From **E** Line Quarter
 Ist. Report **NOV 26 1952**
 Completion
 Remarks **Amerada - DHM**

Spudding Date **11-21-52**

Drlg. Data **Wildont**

8" @ 254 drlg. 1545

J. G. McGEHEE