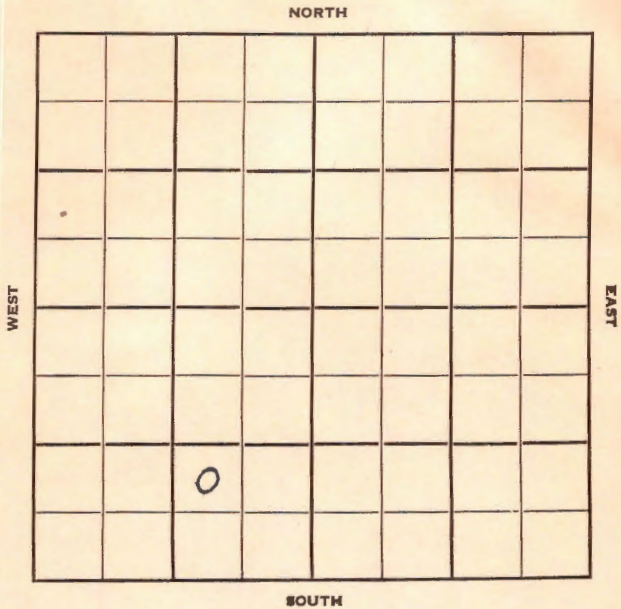


Section 9 Township 25 Range 17WWell No. #1 K. SentneyCompany Stanolind

KANSAS

Sec. 9 Twp. Edwards 25 R. 17W

Well No. #1 K. Sentney Farm

Stanolind Company

MCPC SE/3 SW/21 Contractor


Wildcat
Ft. from N. Line

990' Ft. from S. Line

990' Ft. from E. Line

Ft. from W. Line

NW SE SW

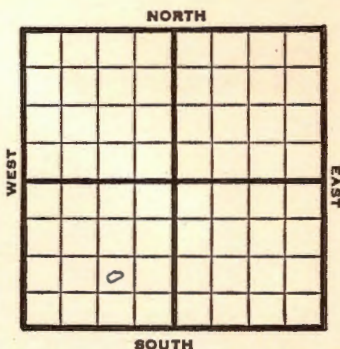

1950

Elev 2133

REPORT

6/21
7/26

Rig up

13" @ 493

Anhy 1654

Lans 3952

Cored 4055-62

Rec 5'11" dol

Cored 4062-4112, rec 50"

DST 4079-4122, opn 1 hr rec 220' SW

Cored 4162-4219, rec 57' dense lime

VSSO 4169-70

Viola 4647

Simp sh 2765

Simp sd 4771-84 Arb 4845-95

DST 4847-95, opn 1 hr rec 225' watercut
mut

Cong 4431

TD 4895

D&A

ABANDONED

Map No. _____ Sec. 9 Twp. 25 R. 17W

 Well No. 1 K. Sentney

Stanolind

Company

McPC

SE/3

SW/21

Contractor

NW SE SW

SECTION PLAT



_____ Ft. from N. Line

990 Ft. from S. Line

990 Ft. from E. Line

_____ Ft. from W. Line

Edwards County

Seismograph

Location _____

 Rig up X

Drilling and Remarks:

RECORD

Cased _____ in., _____ ft.

Sand _____

Gas _____

Oil _____

Total Depth _____

PRODUCTION

1st 24 hrs. Nat. _____

1st 24 hrs. after shot _____

Gas _____ Cu. Ft.

Dry Hole _____

Abandoned _____

Date

JUN 21 1950 19

J. E. TYRA Scout

Kansas

Map No. _____ Sec. 9 Twp. 25 R. 17WWell No. 1 K. SentneyStanolind

Company

Contractor


NW SE SW

E1. 2133
SECTION PLAT

_____ Ft. from N. Line

990 Ft. from S. Line990 Ft. from E. Line

_____ Ft. from W. Line

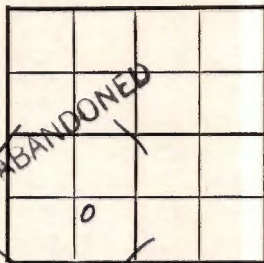Edwards County

Location _____

Rig up _____

Drilling and Remarks:

13" @ 493

Anhy 1654

Lans. 3952

Cored 4055-62

Rec. 5'11" dol.

Cored 4062-4112

Rec. 50"

RECORD

Cased _____ in., _____ ft.

Sand _____

Gas _____

Oil _____

Total Depth 4895

PRODUCTION

1st 24 hrs. Nat. _____

1st 24 hrs. after shot _____

Gas _____ Cu. Ft.

Dry Hole _____

Abandoned _____

Date

JUL 26 1950 19J. E. TYRA Scout

DST 4079-4112

open 1 hr.

Rec: 220' sw

Cored 4162-4219

Rec. 57' dense lime

VSSO 4169-70

Viola 4647

Simp. sh. 4765

Simp. sd. 4771-84

Arb. 4845-95

DST 4847-95

open 1 hr.

Rec. 225' water mut mud

Cong. 4431

D & A

