


Edwards
 Map No. **KANSAS** Sec. *22* Twp. *25* R. *17^w*
 Well No. *1-McCarty* Farm
Welpie Oil et al Company

NORTH

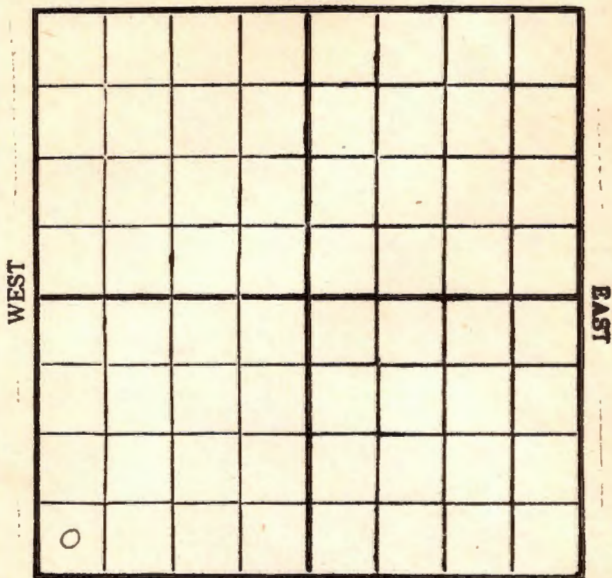

SOUTH

Location _____

Drilling Remarks

Rig Up _____

Drilling Remarks

2787

RECORD

Cased _____ in. _____ ft.

Sand _____

Gas _____

Oil _____

Total Depth _____

PRODUCTION

1st 24 hrs. Nat. _____

1st 24 hrs. after shot _____


Gas _____ cu. ft.

Dry Hole _____

Abandoned _____

Map No. **KANSAS** Sec. 22 Twp. 25 R. 17^w
 Well No. 1- M^e Party Farm _____
Dixie Oil et al Company

NORTH

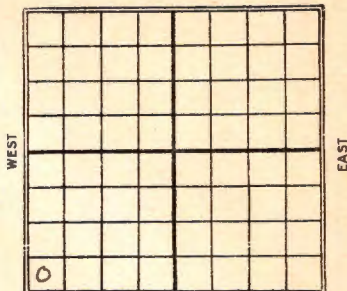

SOUTH

Ft. from N. Line

400 Ft. from S. Line

Ft. from E. Line

400 Ft. from W. Line

1929

Date REPORT

10/16	Location
10/23	
10/30	Big
11/6	Rign up.
11/13	Spud 235'
11/30	Drly 585'
11/27	Rign up
12/4	Spud 165'
12/11	Drly 1700' 13"-1591
12/18	" 2180'
12/23	1/4" H gas 2303-05'
12/30	Drly (2615' = 4 bail water)
1/30	" 3006'
1/8	" 3260' 10"-3028'
1/15	HFW 3516' drly 3565'
1/22	Drly 3610'
1/29	HFW 3700' UIR 8"
2/5	8"-3776 Drly 3828'
2/12	UIR 8"-3927'
2/19	8" at 3964 Drly 4000'
2/26	Drly 4106-8"-4068'

3/5- Only 4182' - 8" - 4110'
 3/12- 2 1/2" 8" - 4270'
 3/19- 8" at 4335 Only 4342'
 3/26- T.D. 4355- P.B.P.
 4/3- 1/2 M gas at 4452 1/2
 Increased to 5 M at 4454
 " to 15 M at 4462
 spray some oil
 4/9- Top Chat 4494
 Well in Chat 4520.
 4/16- Wellg. 4595'
 4/23- " 4600
 4/30- " 4755'
 5/7- " 4903'
 5/14- Run 4 3/4" - 4903'
 5/21- 217W 4914-15"
 Wellg. 4955'
 5/28- T.D. 4960' - P.B.to.
 gas sand 4452-2-
 65.
 6/4 —
 6/11 —
 6/18- S.D. 4465'
 6/25 —
 7/2 —
 7/9- Sand 4452.80
 Comp TD 4500
 8 1/2 M gas

Edwards

Map No. **KANSAS** Sec. 22 Twp. 25 R. 17WWell No. 1 McCartyDixie Oil & Gas Company

Contractor

SECTION PLAT

Ft. from N. Line

400 Ft. from S. Line

Ft. from E. Line

400 Ft. from W. Line

FIRST REPORTS

Location ✓

Rig up

Drilling and Remarks:

RECORD

Cased in., ft.

Sand

Gas

Oil

Total Depth

PRODUCTION

1st 24 hrs. Nat.

1st 24 hrs. after shot

Gas Cu. Ft.

Dry Hole

Abandoned

Date

OCT 16 1929S. J. LEWIS Scout

Map No. **KANSAS** Sec. 22 Twp. 25 R. 12NWell No. 1 Mc CartPixie Oil & Gas Company

Contractor

SECTION PLAT

Ft. from N. Line

400 Ft. from S. Line

Ft. from E. Line

400 Ft. from W. Line

COMPLETED

Location

Rig up

Drilling and Remarks:

8 1/2 M Gas

RECORD

Cased _____ in., _____ ft.

Sand 4452-80

Gas _____

Oil _____

Total Depth 4500

PRODUCTION

1st 24 hrs. Nat. _____

1st 24 hrs. after shot _____

Gas _____ Cu. Ft.

Dry Hole _____

Abandoned _____

Date

JUL 9 1930

192

S. J. LEWIS Scout