


Section 15 Township 25 Range 17W

Well No. #1 Minet Estate

Company W.M.McKnab et al

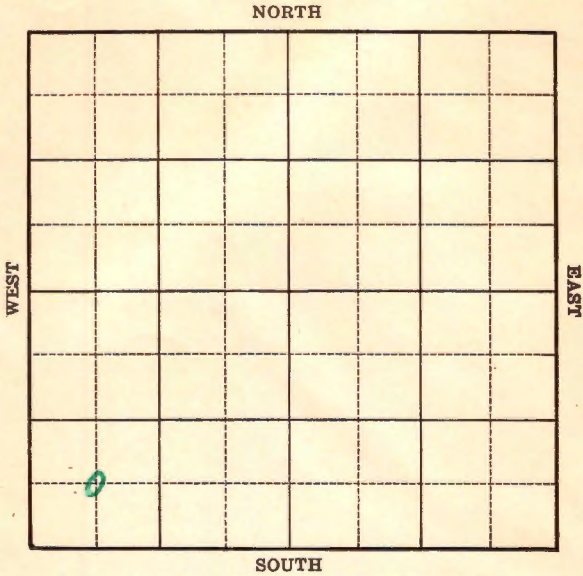

Sec. 15 Twp. 25 R. 17-W

Well No. #1 Minet Estate Farm

W. M. McKnab et al Company


(Wildcat)

         Ft. from N. Line

660 Ft. from S. Line

         Ft. from E. Line

660 Ft. from W. Line

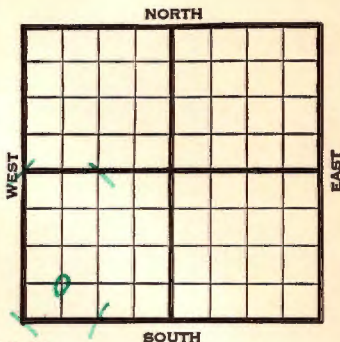

Elev. 2130

1940	REPORT
10/16	Derrick.
10/24	"
10/31	12" - 500' Anhy 1175'
	Drlg. 2325'
11/7	Ft. Riley 2410' Drlg. 3450'
11/14	K.C. 3982' Drlg. 4278'
11/21	Cong. 4497' Miss. 4499'
	Kinderhook 4543'
	Misener 4575' B. Misener 4588'
	Viola 4597' Drlg. 4813' in viola. No shows.
11/26	Arb. 4884'
	T.D. 5010'
	Water.
	ABANDONED

Map No. 84 Sec. 15 Twp. 25 R. 17W

Well No. 1 Minet Estate

W.M. McKnab etal Company  
(Amerada Farmout) Contractor

FIRST REPORT

C SW SW

SECTION PLAT


Ft. from N. Line

660 Ft. from S. Line

Ft. from E. Line

660 Ft. from W. Line

WILDCAT

Location \_\_\_\_\_

RECORD

Rig up \_\_\_\_\_

Cased \_\_\_\_\_ in., \_\_\_\_\_ ft.

Drilling and Remarks:

Sand \_\_\_\_\_

Derrick

Gas \_\_\_\_\_

Oil \_\_\_\_\_

Total Depth \_\_\_\_\_

PRODUCTION

1st 24 hrs. Nat. \_\_\_\_\_

1st 24 hrs. after shot \_\_\_\_\_

Gas \_\_\_\_\_ Cu. Ft.

Dry Hole \_\_\_\_\_

Abandoned \_\_\_\_\_

Date

OCT 16 1940

Map No. 84 Sec. 15 Twp. 25 R. 17W

Well No. 1 Minet Estate

W. M. McKnab etal Company  
(Amerada Farmout)  
Contractor

**ABANDONED**

C SW SW

         Ft. from N. Line

660 Ft. from S. Line

         Ft. from E. Line

660 Ft. from W. Line

WILDCAT

**SECTION PLAT**

•			

Location                                 

Rig up                                 

Drilling and Remarks:

*Cu 84884*  
*Water.*

**RECORD**

Cased          in.,          ft.

Sand                                 

Gas                                 

Oil                                 

Total Depth 5810

**PRODUCTION**

1st 24 hrs. Nat.                         

1st 24 hrs. after shot                         

Gas                                  Cu. Ft.

Dry Hole                                 

Abandoned                                 

Date

NOV 26 1940 19

S. J. LEWIS Scout