FORM 51

Edwards KANSAS

Section 28 Township 25 Range 17 W

Well No. # 1 Milhon

Company ~~Sherrod-Apperson~~

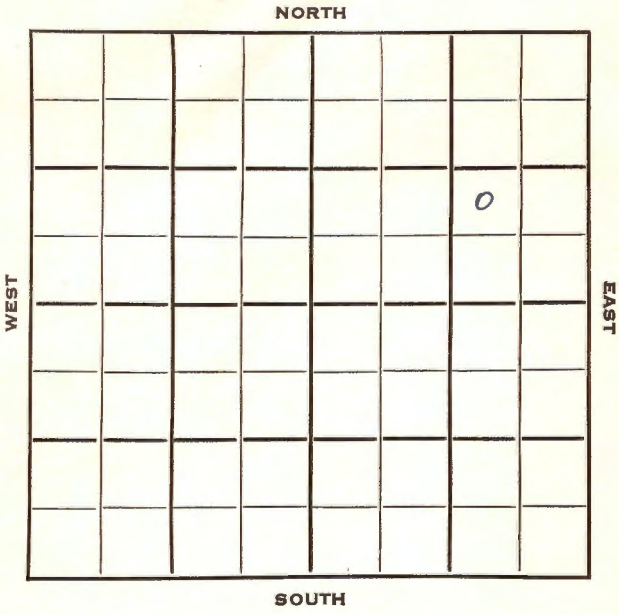

Edwards KANSAS

SEC.	TWP.	R.
28	25	17 W

WELL NO.

1 Milhon FARM

COMPANY

Sherood-Apperson

CONTRACTOR

Barnett

McCarty Pool

_____ Ft. from N. Line

990 Ft. from S. Line

990 Ft. from E. Line

_____ Ft. from W. Line

NW SE NE

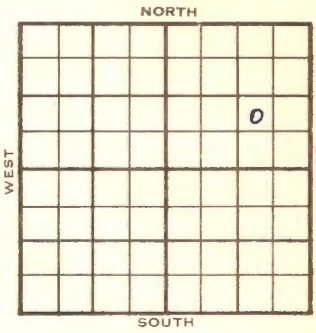

1954	ELEVATION 2118' REPORT
4/14	Spud 4-4-54 8" @ 224 Drlg. 3641'
5/26	Spud 4-4-54 Gas well TD 4620 8" @ 224 Heeb 3816 Br. lime 3962 ans. 3977 B KC 4321 Cong. 4454 DST 4 435-75 open 1 hr, 3,300,000 gas in 30 min. rec 2' mud. 718# Miss. 4500 DST 4475-4501 open 1 hr rec mud. 1193# DST 4500-34, open 1 hr rec 100' GCM 1270# Kh. 4546 Viola 4598 TD 4620 5" @ 4619 CO to 4596 128/4502-34 100,000 gas A-frac 250 M-A 4 MCFG 10 BWPD SP 4470 56/4446-60 3,300,000 gas 4 hr. Comp. shut in gas well. COMPLETED

DX-78

FORM 275 FOR SALE BY KANSAS BLUE PRINT CO.

County Edwards State Kansas

Sec. 28 (Blk. Twp.) 25 (Sur. Rge.) 17W Map No.

Operator Sherrod-Apperson

Well No. 1 Farm Milhon

Elev. 2118 Location NW SE NE

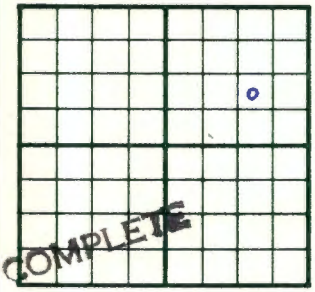

990 Ft. From S Line NE

990 Ft. From E Line Quarter

1st. Report

Completion MAY 26 1954

Remarks McCarty Pool
Barnett - Contr.

Spudding Date 4-4-54

Drlg. Data Gas well TD 4620

8" @ 224 Heeb. 3816 Br. lime 3962
Lans. 3977 B KC 4321 Cong. 4454
DST 4435-75 open 1 hr. 3,300,000 gas in
30 min. Rec. 2' mud 718# Miss. 4500
DST 4475-4501 open 1 hr. Rec. mud
1193# DST 4500-34 open 1 hr. Rec. 100'
gcm 1270# Kh. 4546 Viola 4598
TD 4620 5" @ 4619 CO to 4596
128/ 4502-34 100,000 gas A-frac
250 M-A 4 mcfg 10 bwpd SP 4470
56/ 4446-60 3,300,000 gas 4 hr.
Comp. shut in gas well

J. G. McGEHEE

FORM 275 FOR SALE BY KANSAS BLUE PRINT CO.

County Edwards State Kansas

Sec. 28 (Blk. Twp.) 25 (Sur. Rge.) 17W Map No.

Operator Sherrod-Appersen

Well No. 1 Farm Wilhon

Elev. Location NW SE NE

990 Ft. From S Line NE

990 Ft. From E Line Quarter

1st. Report APR 1 4 1954

Completion

Remarks

Barnett - Contr.

Spudding Date 4-4-54

Drlg. Data McCarty Pool

8" @ 224 drlg. 3641

J. G. McGEHEE