

Edwards

Form 51-5M-9-28-27423

Map No. **KANSAS** Sec. 31 Twp. 25 R. 17 W

Well No. 1- Mc Cartty Farm
British-American Oil Company

NORTH

WEST

EAST

SOUTH

OWDD

Location.....

Rig Up.....

Drilling Remarks

Drilling Remarks

RECORD

Cased..... in..... ft.

Sand.....

Gas.....

Oil.....

Total Depth.....

PRODUCTION

1st 24 hrs. Nat.....

1st 24 hrs. after shot.....

Gas..... cu. ft.....

Dry Hole.....

Abandoned.....

Edwards

2A-5M-5-28-Mid-West


Map No. **KANSAS** Sec. 31 Twp. 25 R. 17^w
 Well No. 1-M^e Party Farm
British American Company

330 Ft. from N. Line

..... Ft. from S. Line

330 Ft. from E. Line

..... Ft. from W. Line

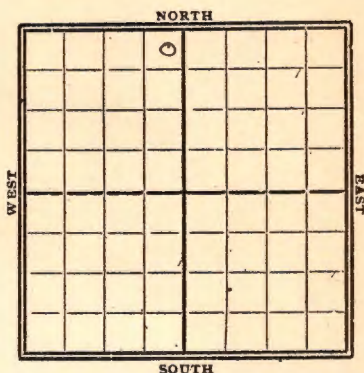

1928

Date	REPORT
11/21	Bldg Rig
11/28	Spud
12/5	no report
12/12	
12/19	Spud & SD.
12/26	no report
1929	
1/2	—
1/9	—
1/16	VIR 10"-1420' - T.D.
1/23	drly 1510' 12"-1500'
1/30	" 2175'
2/6	" 2775'
2/13	fsy tools 2875' T.D.
2/20	
2/27	no report
3/6	8"-3105' drly 3135'
3/13	—
3/20	fsy tools 3695' T.D.
3/27	set 10"-3104'
	VIR 8"-3810' T.D.
4/3	no report

4/10 - wrlg 4160
4/17 - T.D. 4270 - S.D.
4/24 - fsg tools 4325 T.D.
5/1 - wrlg 4415'
5/6 - T.D. 4545' Est. at
10 ~~MA~~ gas, made
40 bbls oil
5/8 - show oil & gas 4525-35
6 ~~MA~~ gas 4535-45
15 bbl oil
S.D. for orders
5/13 - T.D. 4552'
flowed 37 bbls 12 hrs
6 ~~MA~~ gas
5/15 - T.D. 4570' - 14 ~~MA~~ gas
70 bbls oil - shut
down for orders
5/22 - T.D. 4571' 7 ~~MA~~ gas
75 bbls oil - 35.6 gravity
64 temp.
5/29 - S.D.
6/5 - sand 4535-71'
T.D. 4571'
70 bbls oil at
35° gravity
7 ~~MA~~ gas
865# R.P.
Sump.
1930 **OWDD**
7/2 - Old T.D. 4571'
Fsg liner
7/9 ————— 7/6 —————

Map No. Sec. 21 Twp. 23 R. 11

Well No. 1-M-early Farm

British American Company

330 Ft. from N. Line

Ft. from S. Line

230 Ft. from E. Line

Ft. from W. Line

930

Date _____

Date REPORT

423 Utlg by lines.
4571'

7/30	
------	--

7/6	
-----	--

43 T. D. ~~4751~~ 4571
Wall cleaned - will
shoot.

8/30	Drly 4576
------	-----------

8/27 Drilled T.D. 4608
20 bbls oil
3 1/4 m Gas

Map No. **KANSAS** Sec. 81 Twp. 25 R. 12NWell No. 11^c CartyBritish American Oil Company

Contractor

SECTION PLAT

030 Ft. from N. Line

Ft. from S. Line

320 Ft. from E. Line

Ft. from W. Line

COMPLETED

	0		

Location

Rig up

Drilling and Remarks:

Sand 4535 &
45717088 lbs. of 35° gravity
7M Gas865 lbs. Rock P.

RECORD

Cased.....in.,ft.

Sand.....

Gas.....

Oil.....

Total Depth 4571

PRODUCTION

1st 24 hrs. Nat.....

1st 24 hrs. after shot.....

Gas.....Cu. Ft.

Dry Hole.....

Abandoned.....

Date

JUN 5 1928S. J. LEWIS

Scout

Map No. **KANSAS** Sec. 31 Twp. 25 R. 12WWell No. 1M-CartyBritish American Company

Contractor

SECTION PLAT

320 Ft. from N. Line

_____ Ft. from S. Line

330 Ft. from E. Line

_____ Ft. from W. Line

Location _____

Rig up _____

Drilling and Remarks:

Old TD 4571for liner

RECORD

Cased _____ in., _____ ft.

Sand _____

Gas _____

Oil _____

Total Depth _____

PRODUCTION

1st 24 hrs. Nat. _____

1st 24 hrs. after shot _____

Gas _____ Cu. Ft.

Dry Hole _____

Abandoned _____

Date

JUL 2 1930S. J. LEWIS

Scout

Edwards

84 **KANSAS** Map No. _____ Sec. 31 Twp. 25 R. 17 WWell No. 1 Mc Carty
British American Company

Contractor

COMPLETE**SECTION PLAT**

	0		

330 Ft. from N. Line

Ft. from S. Line

330 Ft. from E. Line

Ft. from W. Line

"OWDD"

Location

JD was 4571

Rig up

Drilling and Remarks:

20 Bls Oil

3 1/4 M Gas.

RECORD

Cased _____ in., _____ ft.

Sand _____

Gas _____

Oil _____

Total Depth 4608

PRODUCTION

1st 24 hrs. Nat. _____

1st 24 hrs. after shot _____

Gas _____ Cu. Ft.

Dry Hole _____

Abandoned _____

Date

AUG 27 1920

CHAS. L. SHERWOOD

19

Scout

MAP NO. KANSAS SEC. 31 TWP. 25 R. 17W

WELL NO. 1st Coasty

British American Oil COMPANY

CONTRACTOR

SECTION PLAT

	0		
	0		

380 FT. FROM N. LINE

FT. FROM S. LINE

330 FT. FROM E. LINE

FT. FROM W. LINE

FIRST REPORTS

NENENW

LOCATION

RIG UP

DRILLING AND REMARKS:

Building rig

RECORD

CASED IN. FT.

SAND

GAS

OIL

TOTAL DEPTH

PRODUCTION

1ST 24 HRS. NAT.

1ST 24 HRS. AFTER SHOT

GAS Cu. Ft.

DRY HOLE

ABANDONED

DATE

NOV 21 1928

192

S. J. LEWIS

SCOUT