


Well No. 1-M-Sally Farm

Well No. 1-M-Sally Farm

NORTH

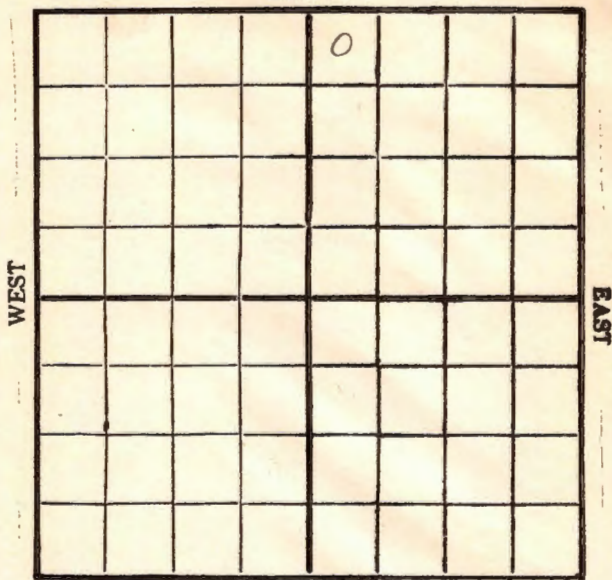

SOUTH

Location _____

Drilling Remarks

Rig Up _____

Drilling Remarks

RECORD

Cased _____ in. _____ ft.

Sand _____

Gas _____

Oil _____

Total Depth _____

PRODUCTION

1st 24 hrs. Nat. _____

1st 24 hrs. after shot_____

Gas _____ cu. ft. _____

Dry Hole_____

Abandoned _____

Map No. KANSAS Sec. 31 Twp. 25 R. 17^w

Well No. 1-M. Party Farm

Barnsdall Oil Company

NORTH

WEST

EAST

SOUTH

330 Ft. from N. Line

_____ Ft. from S. Line

_____ Ft. from E. Line

330 Ft. from W. Line

1929

Date

REPORT

10/23	Location
10/30	Log
11/6	Rig
11/13	—
11/20	—
11/27	Log to 980 Rig & tools
12/4	Log to 1400 Spud
12/11	" 1300
12/18	" 2000'
12/23	SD 2000'
12/30	Wrlg 2548'
1930	
1/8	" 2830'
1/15	" 3125'
1/22	" 3320'
1/29	" 3335'
2/5	" 3640'
2/12	" 3905'
2/19	" 4035'
2/26	" 4131' Ste. seam
3/5	8" Wrlg 4135'

3/12 - Wrlg 4180'

3/19 - " 4290'

3/26 - 6" - 4522 - show oil
4547 - Wrlg.

4/2 - Plg. out 4547

4/9 - Top sand 4530
show oil 4532
T.D. 4536

mkg 3rd gas
Hole filled up 3600 ft
oil in 14 hrs

Made 2 flows one
of ~~40~~ 90 bbl and
the other of 60 bbl

4/14 - T.D. 4553 flowing
about 250 bbl daily

4/16 - T.D. 4554 flows
343 bbl 24 hrs.
37 gravity.

4/23 - Sand 4530-62
TD 4562

shot 20 qt 4527-47

Pump 232 bbl

374 grav
Comp.

Map No. **KANSAS** Sec. 21 Twp. 25 R. 12W

Well No. 84 McCarty

Barnesclaw Oil Company

Contractor

SECTION PLAT

330 Ft. from N. Line

_____ Ft. from S. Line

_____ Ft. from E. Line

330 Ft. from W. Line

		0	

FIRST REPORTS

Location ✓

Rig up _____

Drilling and Remarks:

RECORD

Cased _____ in., _____ ft.

Sand _____

Gas _____

Oil _____

Total Depth _____

PRODUCTION

1st 24 hrs. Nat. _____

1st 24 hrs. after shot _____

Gas _____ Cu. Ft.

Dry Hole _____

Abandoned _____

Date

OCT 23 1929

S. J. LEWIS Scout

Edwards

Map No. **KANSAS** Sec. 31 Twp. 25 R. 12WWell No. 84 McCarthyBarnes & Co. Oil Company

Contractor

SECTION PLAT

320 Ft. from N. Line

Ft. from S. Line

Ft. from E. Line

320 Ft. from W. Line

		0	

CORRECTION

Location

Rig up

Drilling and Remarks:

Reported 21-
25-17W

RECORD

Cased _____ in., _____ ft.

Sand _____

Gas _____

Oil _____

Total Depth _____

PRODUCTION

1st 24 hrs. Nat. _____

1st 24 hrs. after shot _____

Gas _____ Cu. Ft.

Dry Hole _____

Abandoned _____

Date

DEC 4 1929

192

S. J. LEWIS

Scout

Map No. **KANSAS** Sec. 31 Twp. 25 R. 17W

Well No. 11th Carty

Basinella Oil Company

Contractor

SECTION PLAT

830 Ft. from N. Line

..... Ft. from S. Line

..... Ft. from E. Line

830 Ft. from W. Line

		0	

COMPLETED

RECORD

Location

Cased in., ft.

Rig up

Sand 4530 - 4562

Drilling and Remarks:

Gas

Oil

Total Depth 4562

PRODUCTION

1st 24 hrs. Nat.

1st 24 hrs. after shot

Gas Cu. Ft.

Dry Hole

Abandoned

Date

APR 23 1930

S. J. LEWIS

Scout