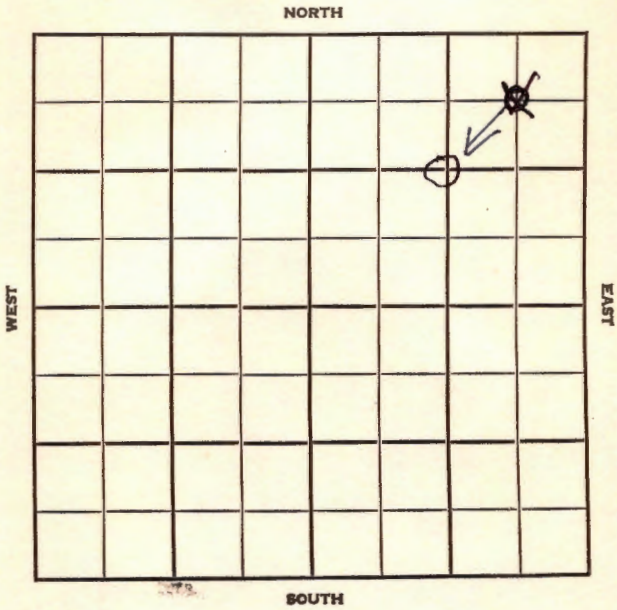


DX 78-1

Section 32-27 Township 25 Range 17W

Well No. 1 Smith

Company Sherrod & Apperson



SEC. <u>32</u> <u>27</u>	TWP. <u>25</u>	R. <u>17W</u>
-----------------------------	----------------	---------------

WELL NO.

1 Smith

FARM

COMPANY

Sherrod & Apperson

CONTRACTOR

Barnett

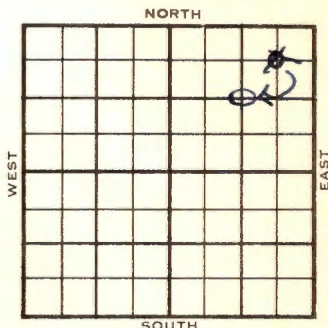
Wildcat

1320
660 Ft. from N. Line

Ft. from S. Line

1320
660 Ft. from E. Line

Ft. from W. Line

C NE/4
C NE NE

1954

ELEVATION

1235'

REPORT

8/4

Location

1955
4/13

Spud 8-21-54 - Temp. Abd.

TD 4560'

8-5/8" @ 228'

Anhy 1170', Cong. 4503'

TD 4560'

5" @ 4503'

Lans. 4008', Marm. 4316'

TD 4406'

DD 4560'

sd-oil-frac

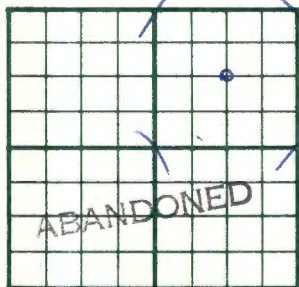
S/1 1/2 boph 1 bw

Heeb. 3862', Doug. 3900', Br lime
3986'

P/3 to 5 bopd

Temp. abd.

ABANDONED

County Edwards State KansasSec. 32 (Blk. Twp.) 25 (Sur. Rge.) 17W Map No. Operator Sherrod & AppersonWell No. 1 Farm SmithElev. 1235 Location C NE/41320 Ft. From N Line NE1320 Ft. From E Line Quarter1st. Report Completion APR 13 1955Remarks WildcatBarnett - Contr.Spudding Date 8-21-54Drilg. Data Temp. abd. TD 45608 5/8" @ 228 Anhy 1170 Cong. 4503TD 4560 5" @ 4503 Lans. 4008Marm. 4316 TD 4406 DD 4560 sd-oil-fracS/ 1 1/2 boph 1 bw Heeb. 3862 Doug. 3900Br. lime 3986 P/ 3 to 5 bopdTemp. abd.

FABEN GILSTRAP

County **Edwards** State **Kansas**

Sec. **27** (Blk. **25** (Sur. **17W** Map No.

Operator **Sherrod & Apperson**

Well No. **1** Farm **Smith**

Elev.	Location	C NE NE
600	100	
700	200	
800	300	
14700	14200	

660 Ft. From N Line NE

[illegible]

1st. Report AUG 4 1954

[illegible]

FIRST REPORT	Remarks
--------------	---------

--	--	--	--	--	--

Spudding Date

Drig. Data **Wildcat**

Location

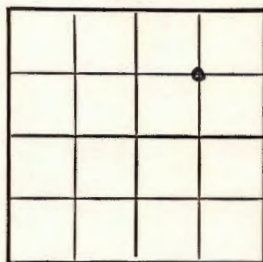
J. G. McGEHEE

Kansas

Map No. _____ Sec. 32 Twp. 25 R. 17WWell No. 1 Smith_____
Sherrod & Apperson Company_____
CORRECTION Contractor

C NE/4

SECTION PLAT

1320 Ft. from N. Line

_____ Ft. from S. Line

1320 Ft. from E. Line

_____ Ft. from W. Line

Edwards County

Location _____

Rig up _____

Drilling and Remarks:

Reported

C NE NE

27-25-17W

RECORD

Cased _____ in., _____ ft.

Sand _____

Gas _____

Oil _____

Total Depth _____

PRODUCTION

1st 24 hrs. Nat. _____

1st 24 hrs. after shot _____

Gas _____ Cu. Ft.

Dry Hole _____

Abandoned _____

Date

FABEN GILSTRAP

SEP 1 1954 19

Scout