

GLOBE OILWELL CEMENTING, Inc.

TEMPERATURE SURVEY

Date 10-18-67 Place Kinsley, Kansas

Company Name Stan Bell Order No. _____

Mail Address 222 Brown Bldg. City Wichita, State Kansas

Owner of Well same Contractor Gabbert & Jones


Well No. 1 Farm Elston County Edwards Sec. _____ Tp. _____ Rge. _____

Depth of Well 4457 Depth of Csg. Cmtd. 4382 Casing New Used } Size 5 1/2 Size of Hole 7-7/8
Weight 14 Amount of Cement 100

Kind of Cement 50-50 Poz. w. salt

Top Cement 3511 Run No. 1 { Rotary }
Cable }

Survey From G.L. Ft. To 4361 Ft. }

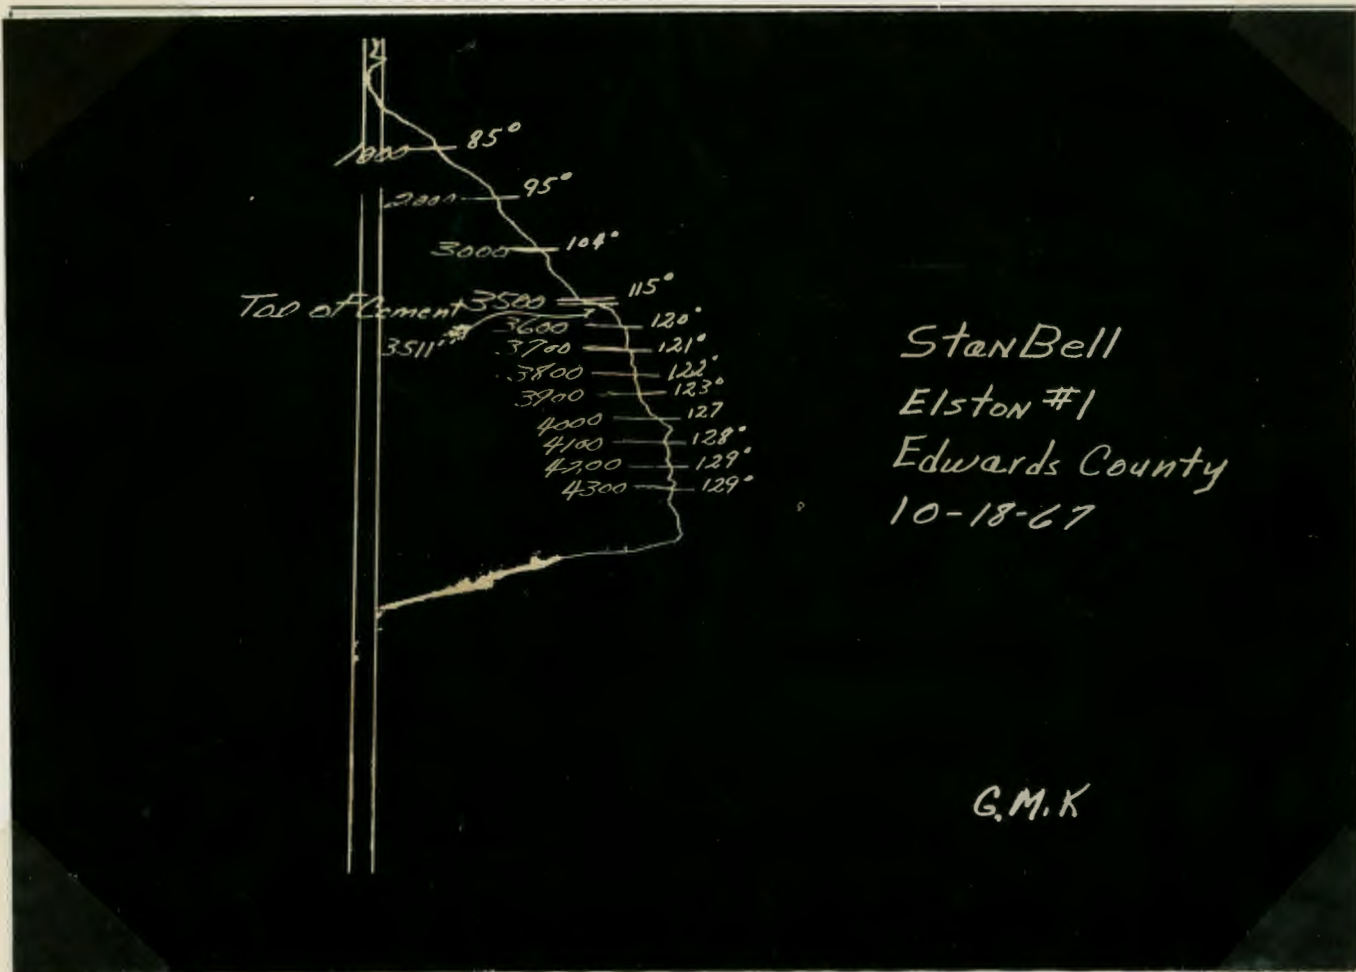

This is an actual photograph of recorder chart.