

Edwards

KANSAS

SECTION 22 TOWNSHIP 25 RANGE 19W

WELL NO. #1 Jack Moletor

COMPANY E. A. Smith

NORTH

0							

WEST

EAST

SOUTH

Edwards

KANSAS

SEC.

22

TWP.

25

R.

19W

WELL NO.

#1 Jack Moletor

FARM

COMPANY

E.A. Smith

CONTRACTOR

Unit Drlg.

WILDCAT


_____ Ft. from N. Line

_____ Ft. from S. Line

_____ Ft. from E. Line

_____ Ft. from W. Line

SW SW SW

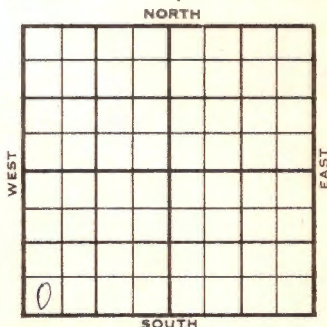

1956

ELEVATION

REPORT

5-16

10" @ 218
Drlg. 3382

Co.

County Edwards Elev. 2201Sec. 22 Twp. 25 Rge. 19WCompany E. A. SmithFarm Name Jack Moletor No. 1

TOPS	DEPTH	LOG	DATUM	Loc. in Sec.
Anh.				SW SW SW
Tr.				
Dg.				
Bl.				
L.				
K.C.	4110			Geol.
B.K.C.				Conte
Ce.				Unit Drlg.
C.				
M.				Pool
M.				Wildcat
K.				
Mz.				
Ma.				
V.				
S.				ABANDONED
S.				
A.	5177			SEP 26 '56
R.				
Pe.				
G.				
T.D.	5210			

No.

No.

Sec.

T.

R.

Date Comm.

10" @ 218 drlg. 3382 MAY 23 '56 Tite

MAY 29 '56

ID 4900

JUN. 6 '56

RTD 5210

JUN 13 '56 ✓

JUN 20 '56 ✓

JUN 27 '56

JUL 3 '56

JUL 11 '56

JUL 18 '56

D & A

Tite

JUL 20 '56

AUG 1 '56

AUG 8 '56

AUG 15 '56

AUG 22 '56

AUG 29 '56

SEP 5 '56

10 3/4

225/300

SEP 12 '56

SEP 19 '56

SEP 26 '56

D & A

County Edwards Elev. _____
 Sec. 22 Twp. 25 Rge. 19W
 Company E. A. Smith
 Farm Name Jack Moletor No. 1

TOPS	DEPTH	LOG	DATUM	Loc. in Sec.
Anh.				SW SW SW
TP.				
H.				
Tr.				
Dg.				
Bl.				
L.				Geol. _____
K.C.				Contr. _____
B.K.C.				Unit Drlg.
Ce.				
C.				
M.				Pool
M.				Wildcat
K.				
Mz.				
Mo.				
V.				
S.				
S.				
A.				
R.				
Pe.				
G.				
T.D.				

FIRST REPORT

MAY 16 '55

Date Comm. 10" @ 218 drlg. 3382

MAY 5 1955

R. G. R.