

5M-4-27-274
KANSAS

Map No. _____ Sec. 22 Twp. 23 R. 19a

Well No. 1-Tangail Farm
Wilcox & Amherst Company

NORTH

WEST

EAST

SOUTH

Location _____

Drilling Remarks

Rig Up

Drilling Remarks

5973

RECORD

Cased _____ in. _____ ft.

Sand

Gas

Oil

Total Depth

PRODUCTION

1st 24 hrs. Nat.

1st 24 hrs. after shot_____


Gas _____ cu. ft.

Dry Hole

Abandoned

Map No. **KANSAS** Sec. 32 Twp. 25 R. 19W
 Well No. 1 - Jansil Farm
Wilcox & Amerada Company

NORTH

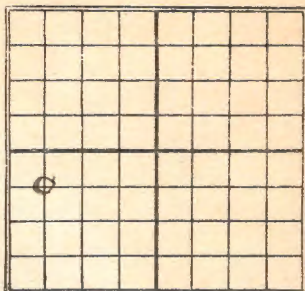

660 Ft. from N. Line

_____ Ft. from S. Line

_____ Ft. from E. Line

660 Ft. from W. Line

1928

Date

REPORT

<u>6/27</u>	<u>R.O.G.</u>
<u>7/3</u>	<u>Bldg rig</u>
<u>7/11</u>	<u>Spud</u>
<u>7/18</u>	<u>Spud 130</u>
<u>7/25</u>	<u>Drly 310</u>
<u>8/1</u>	<u>" 645</u>
<u>8/7</u>	<u>" 778</u>
<u>8/15</u>	<u>" 1070</u>
<u>8/22</u>	<u>" 1515</u>
<u>9/5</u>	<u>" 1770</u>
<u>9/12</u>	<u>" 2070</u>
<u>9/19</u>	<u>" 2640</u>
<u>9/26</u>	<u>" 3050'</u>
<u>10/3</u>	<u>" 3180'</u>
<u>10/10</u>	<u>" 3275'</u>
<u>10/17</u>	<u>" 3315'</u>
<u>10/24</u>	<u>S.D. 3315 T.D.</u>
<u>10/31</u>	<u>T.D. 3318' UIR 8"</u>
<u>11/7</u>	<u>Sly out 3525 T.D.</u>
<u>11/14</u>	<u>T.D. 3525' UIR 8"</u>
<u>11/21</u>	<u>Drly 3565'</u>
<u>11/28</u>	<u>" 3770'</u>

12/5 - no report
 12/12
 12/19 - drlg 3815'
 12/26 " 3815'
 1929
 1/2 - " 4000'
 1/9 " 4050'
 1/16 VIR 8" - 4120' - T.D.
 1/23 - drlg 4165'
 1/30 - " 4245'
 2/6 - VIR 6" - 4285' T.D.
 2/13 - drlg 4370'
 2/20 VIR 6" - 4445' - T.D.
 2/27
 3/5 6" - 4454' - drlg 4475'
 3/12
 3/20 - Drlg 4730' - HFW
 3/27 - VIR 5" - 4776' - T.D.
 4/3 Drlg 4856'
 4/10 " 4925'
 4/17 T.D. 5000' - S.D.
 4/24
 5/1 drlg 5045'
 5/8 Base miss line 5107'
 drlg 5121'
 5/15 drlg 5187'
 5/22 WR. 5" - 5195'
 5/29
 6/5 T.D. 5195' - HFW
 dry & Abandon

Map No. 1 **KANSAS** Sec. 32 Twp. 25 R. 19W

Well No. 1 Tansil

Philco Oil & Amerac Petroleum Company

Contractor

SECTION PLAT

660 Ft. from N. Line

----- Ft. from S. Line

----- Ft. from E. Line

660 Ft. from W. Line

0			

FIRST REPORTS

Location -----

Rig up -----

Drilling and Remarks:

R.O.G.
5000 ft test

RECORD

Cased ----- in., ----- ft.

Sand -----

Gas -----

Oil -----

Total Depth -----

PRODUCTION

1st 24 hrs. Nat. -----

1st 24 hrs. after shot. -----

Gas ----- Cu. Ft.

Dry Hole -----

Abandoned -----

Date

JUN 27 1928

S. J. LEWIS

Scout

Map No. **KANSAS** Sec. 32 Twp. 25 R. 19WWell No. 1 TannilHelco, O & G & American Company

Contractor

SECTION PLAT

660 Ft. from N. Line

Ft. from S. Line

Ft. from E. Line

660 Ft. from W. Line

ABANDONED

Location.....

Rig up.....

Drilling and Remarks:

5195 NAWD & H

RECORD

Cased.....in.,ft.

Sand.....

Gas.....

Oil.....

Total Depth 5795

PRODUCTION

1st 24 hrs. Nat.....

1st 24 hrs. after shot.....

Gas.....Cu. Ft.

Dry Hole.....

Abandoned.....

Date

JUN 5 1929S. J. LEWIS Scout