

Sedgwick


KANSAS

FORM 51 5M BRIX

Section 6 Township 25 Range 2W

Well No. #1, Friends Univ.

Company Atlantic Oil Prod.

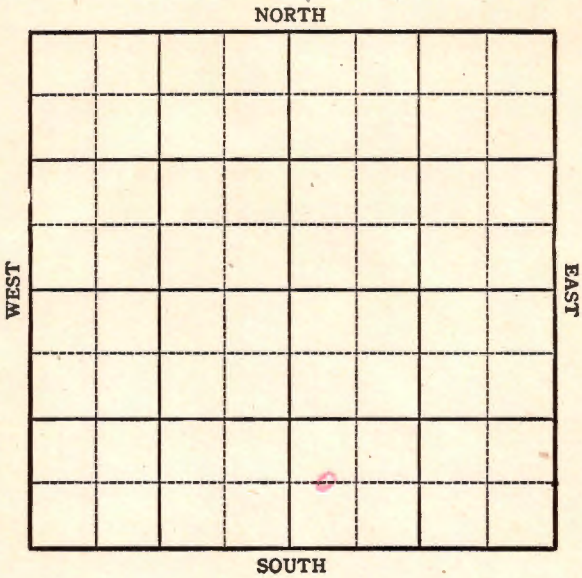

KANSAS

Sedgwick

FORM 252-A
5M 3-44 PETROLSec. 6 Twp. 25 R. 2WWell No. #1, Friends Univ. FarmAtlantic Oil Prod. Company

NORTH

 Ft. from N. Line660 Ft. from S. Line Ft. from E. Line330 Ft. from W. Line

WEST

EAST

SOUTH

Elev. 1406

REPORT

1944

6/7 256'. Repairing

6/15 10" @ 442
Drlg. 17606/21 **Lans 2560-3010**

6/28 Drlg 3315

7/19 **Arb. 4047**
TD 4130**ABANDONED**

KANSASPool Name WildcatMap No. 39 Sec. 6 Twp. 25 R. 2WWell No. 1 Friends UniversityAtlantic Oil Prod. CompanyABANDONED ContractorC W L SW SE

SECTION PLAT

		6	

 Ft. from N. Line660 Ft. from S. Line Ft. from E. Line330 Ft. from W. LineSedgwick CountyLocation Rig up

Drilling and Remarks:

Or 44047

RECORD

Cased in., ft.Sand Gas Oil Total Depth 4120

PRODUCTION

1st 24 hrs. Nat. 1st 24 hrs. after shot Gas Cu. Ft.Dry Hole Abandoned

Date


JUL 1 9 1944 19S. J. LEWIS Scout

KANSASPool Name WildcatMap No. 39 Sec. 6 Twp. 25 R. 2WWell No. 1 Friends Univ.Atlantic Oil Prod. CompanyFIRST REPORT

Contractor

C W L SW SE

SECTION PLAT

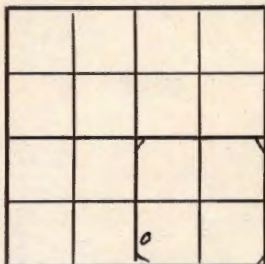

_____ Ft. from N. Line

660 Ft. from S. Line

_____ Ft. from E. Line

330 Ft. from W. LineSedgwick County

Location _____

Rig up _____

Drilling and Remarks:

256 - Repairing

RECORD

Cased _____ in., _____ ft.

Sand _____

Gas _____

Oil _____

Total Depth _____

PRODUCTION

1st 24 hrs. Nat. _____

1st 24 hrs. after shot _____

Gas _____ Cu. Ft.

Dry Hole _____

Abandoned _____

Date

JUN 7 1944 19 _____S. J. LEWIS Scout