


Sedgwick

KANSAS

SECTION 13 TOWNSHIP 25 RANGE 2W

WELL NO. #1 Block

COMPANY Bedell & Catt

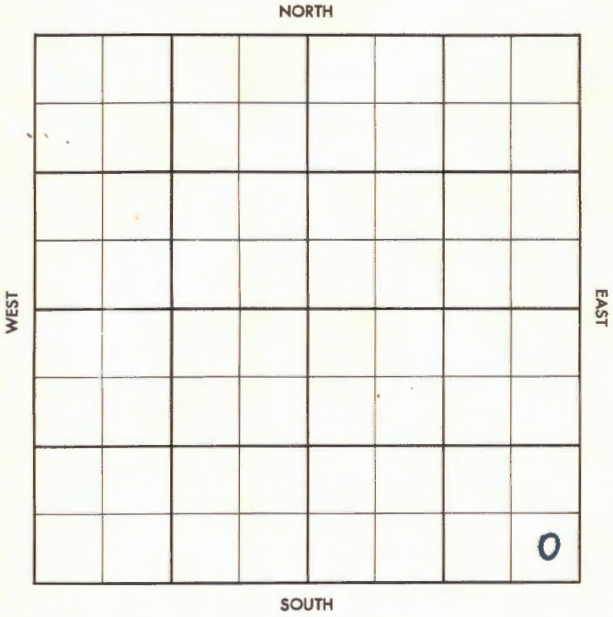

Sedgwick

KANSAS

SEC. 13	TWP. 25	R. 2W
------------	------------	----------

WELL NO. #1 Block FARM

COMPANY
Bedell & Catt

CONTRACTOR
Co. Tools

Bentley


_____ Ft. from N. Line

_____ Ft. from S. Line

_____ Ft. from E. Line

_____ Ft. from W. Line

SE SE SE

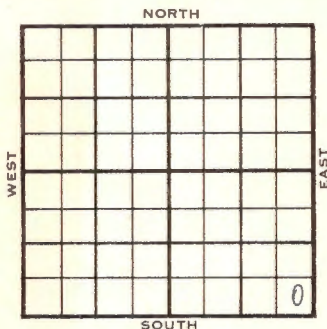

1956	ELEVATION 1376'	REPORT
------	---------------------------	--------

4-25 8" @ 325 w/246
Drlg. 820

5-2 DST 2891-96 op 1 hr. rec. 124' MSW,
BHP 1170/20
DST 2924-33 op 90 min. rec. 45' SOCWM /
60' VSOCMSW, FP 0-60#, BHP 1110/20"
D&A
BL 2485
L. 2503
KC 2771
TD 2993

ABANDONED

County Sedwick Elev. _____
 Sec. 13 Twp. 25 Rge. 2W
 Company Bardell & Catt
 Farm Name Block No. 1

TOPS	DEPTH	LOG	DATUM	Loc. in Sec.
Anh.				SE SE SE
TP.				
H.				
Tr.				
Dg.				
Bl.				
L.				Geol. _____
K.C.				Contr. _____
B.K.C.				Co. tools
Ce.				
C.				
M.				Pool
M.				Bentley
K.				
Mz.				
Mq.				
V.				
S.				
S.				
A.				
R.				
PE.				
G.				
TD.				

FIRST REPORT
 APR 25 '56

Date Comm. 8" @ 325/246 drlg. 820

8201 S. YAW

R. G.

Handwritten signature

Co.
 Sec.
 No.
 Sec.
 T.
 R.

County Sedgwick Elev. 1376
 Sec. 13 Twp. 25 Rgs. 2W
 Company Bedell & Catt
 Farm Name Block No. 1

TOPS	DEPTH	LOG	DATUM	Loc. in Sec.
Anh.				SE SE SE
Tr.				
Dg.				
Bl.	2485		1109	
L.	2503		1127	Geol.
K.C.	2771		1395	
B.K.C.				Contr.
Ce.				Co. tools
C.				
M.				Pool
M.				Bentley
K.				<div style="border: 1px dashed black; padding: 10px; text-align: center;"> ABANDONED </div>
Mz.				
Mo.				
V.				
S.				
S.				
A.				
R.				
Pe.				
G.				
TD	2933			

Date Comm. MAY 2 1956

8" @ 325/246 drlg. 820 MAY 2 '56 DST
2891-96 1 1/2 124' MSW BHP
1170/20 DST 2924-33 90" ms
45' 500W M + 60' V 500 M SW FP
0-60 DHP 1110/20 "

DEA