

SECTION 24 TOWNSHIP 25 RANGE 2 W

WELL NO. #2 Elliott

COMPANY Hinton & Frey

NORTH

							0

WEST

EAST

SOUTH

Sedgwick

KANSAS

SEC. 24	TWP. 25	R. 2W
------------	------------	----------

WELL NO.

#2 Elliot

FARM

COMPANY

Hinton & Frey

CONTRACTOR


Prime

\_\_\_\_\_ Ft. from N. Line

\_\_\_\_\_ Ft. from S. Line

\_\_\_\_\_ Ft. from E. Line

\_\_\_\_\_ Ft. from W. Line

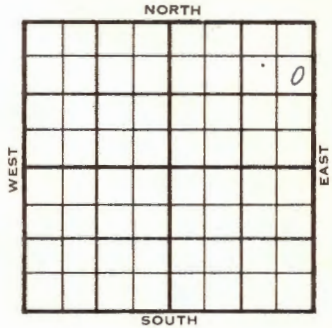

SE NE NE

1956	ELEVATION 1379 RB	REPORT
------	----------------------	--------

1-25

RUR

2-8

Comm. 1-23-56

8 5/8" @ 329 w/225

DST 2876-90 op 2 hrs. rec. 57' SOCM  
plus 124' M&SW, FP 5-90, BHP 1140/20"

DST 2927-36 op 1 hr. rec. 10' SO&MCW  
plus 93' MSW plus 372' SW, FP 30-30  
BHP 1180/20

D & A

H. 2255

Tr. 2267

Form. 2288

Dg Li. 2312

BL 2473

Sd 2480-81

Lsg. 2487

KC 2770

TD 2936'

**ABANDONED**

County Sedgwick Elev. \_\_\_\_\_  
 Sec. 24 Twp. 25 Rge. 2W  
 Company Hinton & Frey  
 Farm Name Elliott No. 2

TOPS	DEPTH	LOG	DATUM
Anh.			
Tp.			
H.			
Tr.			
Dg.			
Bl.			
L.			
K.C.			
B.K.C.			
Ce.			
C.			
M.			
M.			
K.			
Mz.			
Me.			
V.			
S.			
S.			
A.			
R.			
Pe.			
G.			
T.D.			

Loc. in Sec. SE NE NE

Geol. \_\_\_\_\_  
 Contr. Prime

Pool \_\_\_\_\_

			0
FIRST REPORT			
JAN 25 '56			

Date Comm. RUR

*[Handwritten signature]*

Co.  
No.  
Sec.  
T.  
R.

County Sedwick Elev. 1379 RB  
 Sec. 24 Twp. 25 Rge. 2W  
 Company Hinton & Frey  
 Farm Name Elliott No. 2

TOPS	DEPTH	LOG	DATUM	Loc. in Sec.
Ank				<b>SE NE NE</b>
Tr.				
H.	2255			
Tr.	2267			
Dp. <u>EACM</u>	2282			
Dr. <u>Dg 61</u>	2312			
L. <u>B2</u>	2473		1094	
Co. <u>sd</u>	2481-87		1121	Geol.
SPC-LS9	2487		1108	Conts
Co. <u>KC</u>	2770		1391	<b>Prime</b>
C.				
M.				
N.				
K.				
Mo.				
Mo.				
V.				
S.				
S.				
A.				
R.				
PC.				
G.				
30	2976			

**ABANDONED**

Date Com. **FEB 8 1956**  
**RUR FEB 1 '56 1-23-56 P5/E 329**  
**225  $\phi$  2795 FEB 8 '56 DST 2876**  
**-90 2 hrs. rec 57' 50cm + 124'**  
**M $\phi$ SW FP 5-90 BHP 1140/20"**  
**DST 2927-36 1hr. rec 10' 50"**  
**MCW + 93' MSW + 372' SW FP**  
**30-30 BHP 1180/20**  
*W.A.A.*