

STATE CORPORATION COMMISSION OF KANSAS
OIL & GAS CONSERVATION DIVISION
WELL COMPLETION OR RECOMPLETION FORM
ACO-1 WELL HISTORY
DESCRIPTION OF WELL AND LEASE

Operator: License # 5290
Name Hinkle Oil Company
Address 1016 Union Center Building
City/State/Zip Wichita, Kansas 67202

Purchaser Undecided at this time
Derby Refining Co.

Operator Contact Person Orvie Howell
Phone (316) 267-0231

Contractor: License # 5302
Name Red Tiger Drilling Company

Wellsite Geologist Orvie Howell
Phone (316) 267-0231

Designate Type of Completion
 New Well Re-Entry Workover
 Oil SWD Temp Abd
 Gas Inj Delayed Comp.
 Dry Other (Core, Water Supply etc)
If OWWO: old well info as follows:
Operator
Well Name
Comp. Date Old Total Depth


WELL HISTORY

Drilling Method:
 Mud Rotary Air Rotary Cable
1/21/89 2/1/89 3/27/89
Spud Date Date Reached TD Completion Date
4860 4818
Total Depth PBTD
Amount of Surface Pipe Set and Cemented at 361 feet
Multiple Stage Cementing Collar Used? Yes No
If yes, show depth set feet
If alternate 2 completion, cement circulated from feet depth to w/SX cmt
Cement Company Name
Invoice #

API NO. 15-057-20,465
County Ford
SW SW SE Sec. 24 Twp. 25S Rge. 21 East
330 Ft North from Southeast Corner of Section
2310 Ft West from Southeast Corner of Section
(Note: Locate well in section plat below)

Lease Name Weiss Well # 1
Field Name Wildcat
Producing Formation Mississippian-Osage
Elevation: Ground 2284 KB 2289

Section Plat

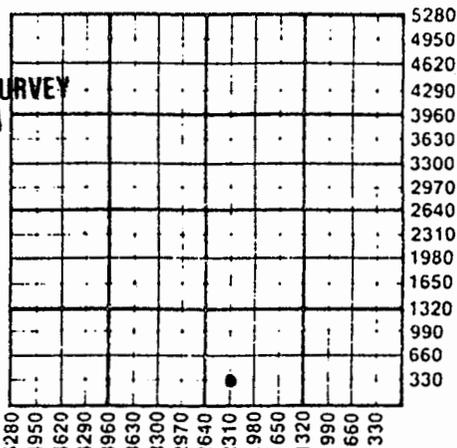

KANSAS GEOLOGICAL SURVEY
WICHITA BRANCH

RECEIVED
STATE CORPORATION COMMISSION

MAR 28 1989

CONSERVATION DIVISION
Wichita, Kansas

APR 21 1989

WATER SUPPLY INFORMATION

Disposition of Produced Water: Disposal
Docket # Repressuring

Questions on this portion of the ACO-1 call:

Water Resources Board (913) 296-3717

Source of Water:
Division of Water Resources Permit # T89-037

Groundwater 300 Ft North from Southeast Corner
(Well) 2000 Ft West from Southeast Corner of
Sec 24 Twp 25S Rge 21 East West
John Indiek, Offerle, Kansas 67563
 Surface Water Ft North from Southeast Corner
(Stream, pond etc) Ft West from Southeast Corner
Sec Twp Rge East West
 Other (explain)
(purchased from city, R.W.D. #)

INSTRUCTIONS: This form shall be completed in triplicate and filed with the Kansas Corporation Commission, 200 Colorado Derby Building, Wichita, Kansas 67202, within 120 days of the spud date of any well. Rule 82-3-130, 82-3-107 and 82-3-106 apply. Information on side two of this form will be held confidential for a period of 12 months if requested in writing and submitted with the form. See rule 82-3-107 for confidentiality in excess of 12 months. One copy of all wireline logs and drillers time log shall be attached with this form. Submit CP-4 form with all plugged wells. Submit CP-111 form with all temporarily abandoned wells.

requirements of the statutes, rules and regulations promulgated to regulate the oil and gas industry have been fully complied with and the statements herein are complete and correct to the best of my knowledge.

Signature Orvie Howell
Title General Manager - Geologist Date 3/27/89

Subscribed and sworn to before me this 27th day of March 1989
Notary Public Melanie Frieden

Date Commission Expires January 30, 1992

MELANIE FRIEDEN
NOTARY PUBLIC
STATE OF KANSAS
My Appl. Exp. 1-30-92

K.C.C. OFFICE USE ONLY
 Letter of Confidentiality Attached
 Wireline Log Received
 Drillers Timelog Received
Distribution
 KCC SWD/Rep NGPA
 KGS Plug Other
(Specify)

Sec 24 Twp 25S Rge 21E