

SIDE ONE

STATE CORPORATION COMMISSION OF KANSAS
OIL & GAS CONSERVATION DIVISION
WELL COMPLETION OR RECOMPLETION FORM
ACO-1 WELL HISTORY
DESCRIPTION OF WELL AND LEASE

Operator: License # 5015
Name Hellar Drilling Co., Inc.
Address 125 No. Market, Suite 1422
City/State/Zip Wichita, Kansas 67202

Purchaser Clear Creek, Inc.
McPherson, Kansas

Operator Contact Person D. L. Hellar
Phone (316) 267-2845

Contractor: License # 5104
Name Blue Goose Drilling Co., Inc.

Wellsite Geologist Bob Douglass
Phone (316) 263-7125

Designate Type of Completion

☒ New Well ☐ Re-Entry ☐ Workover
☒ Oil ☐ SWD ☐ Temp Abd
☐ Gas ☐ Inj ☐ Delayed Comp.
☐ Dry ☐ Other (Core, Water Supply etc.)

If OMWO: old well info as follows:

Operator
Well Name
Comp. Date Old Total Depth

WELL HISTORY

Drilling Method:

☒ Mud Rotary ☐ Air Rotary ☐ Cable

11/17/88 11/29/88 12/23/88
Spud Date Date Reached TD Completion Date

5329 4776
Total Depth PBTD

Amount of Surface Pipe Set and Cemented at 384 feet
Multiple Stage Cementing Collar Used? Yes ☒ No

If yes, show depth set feet
If alternate 2 completion, cement circulated
from feet depth to w/ SX cmt
Cement Company Name
Invoice #

API No. 15-057-20,462

County Ford
NW
NE SW SE Sec. 26 Twp. 25 Rge. 21 East
X West

990 Ft North from Southeast Corner of Section
2310 Ft West from Southeast Corner of Section
(Note: Locate well in section plat below)

Lease Name Hermann "A" Well # 1


Field Name Coon Creek North

Producing Formation Mississippi (Warsaw)

Elevation: Ground 2307 KB 2317

Section Plat

MAR 23 1989

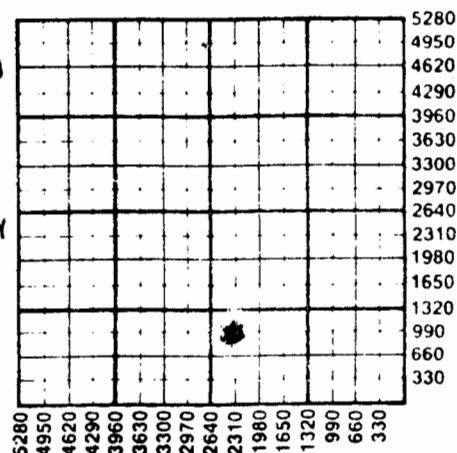

WATER SUPPLY INFORMATION

Disposition of Produced Water: None Disposal
Docket # Repressuring

Questions on this portion of the ACO-1 call:

Water Resources Board (913) 296-3717

Source of Water:

Division of Water Resources Permit #

Groundwater Ft North from Southeast Corner
(Well) Ft West from Southeast Corner of
Sec Twp Rge East West

Surface Water Ft North from Southeast Corner
(Stream, pond etc) Ft West from Southeast Corner
Sec Twp Rge East West

☒ Other (explain) Hauled water
(purchased from city, R.W.D. #)

INSTRUCTIONS: This form shall be completed in triplicate and filed with the Kansas Corporation Commission, 200 Colorado Derby Building, Wichita, Kansas 67202, within 120 days of the spud date of any well. Rule 82-3-130, 82-3-107 and 82-3-106 apply.

Information on side two of this form will be held confidential for a period of 12 months if requested in writing and submitted with the form. See rule 82-3-107 for confidentiality in excess of 12 months.

One copy of all wireline logs and drillers time log shall be attached with this form. Submit CP-111 form with all temporarily abandoned wells.

CONSERVATION DIVISION