

10-25-22W

KANSAS GEOLOGICAL SOCIETY  
KANSAS WELL LOG BUREAU - KANSAS WELL SAMPLE BUREAU  
KANSAS GEOLOGICAL SOCIETY BUILDING  
508 EAST MURDOCK - WICHITA, KANSAS

COMPANY MARDEN & LONG

SEC. 10 T. 25 R. 22W  
LOC. C SE SW

FARM Hornung

NO. 1

COUNTY Ford

TOTAL DEPTH 4950'


COMM. 5-8-68

COMP. 5-24-68

SHOT OR TREATED

CONTRACTOR Strata Drlg.

ISSUED 10-19-68

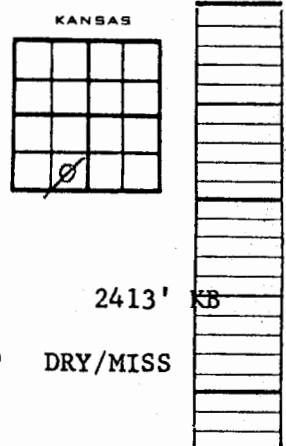

CASING

20	10	
15	8	5/8" 287' cem w/ 160 sx
12	6	
13	5	

ELEVATION 2413' KB

PRODUCTION DRY/MISS

FIGURES INDICATE BOTTOM OF FORMATIONS

Clay & Sand	0	100
Clay & Blue Shale	100	315
Red Bed & Blue Shale	315	565
Red Bed, Shale & Shells	565	1345
Shale	1345	1655
Shale & Broken Lime	1655	2015
Shale & Shells	2015	2430
Lime & Shale	2430	2737
Lime	2737	3127
Lime & Shale	3127	3970
Lime	3970	4500
Lime & Chert	4500	4533
Lime	4533	4769
Lime & Chert	4769	4950

Ran 287.45' of new 8-5/8" surface casing; set and cemented at 287.45' with 160 sacks of cement and 2% gel. Plug down at 4:00 A. M. May 10, 1968.

Total Depth 4950'

Ran electric log.

D. & A.

Plugged hole as follows: Plugged with mud from 4950' to 1130'; plugged at 1130' with 100 sacks of cement and mud to 290'; plugged at 290' with 30 sacks of cement and mud to 40'; plugged at 40' with 15 sacks of cement and hulls. Plug down at 10:30 P. M. May 24, 1968.

TOPS: LOG

Heebner	4057
Lansing	4164
Marmaton	4562
Cherokee	4690
Spergen	4794
Warsaw	4818
Osage	4908
RTD	4948
LTD	4950