

Sec. 21 Twp. 25 Range 24 W

#1 Henthorn

Kansas Geological Society


Swain, et al.

Skelly Scout Tickets

Map No. **KANSAS** Sec. 21 Twp. 25R 24W

Well No. 1 Hawthorn Farm  
Swann et al Company

1320 Ft. from N. Line  
\_\_\_\_\_ Ft. from S. Line  
\_\_\_\_\_ Ft. from E. Line  
1320 Ft. from W. Line

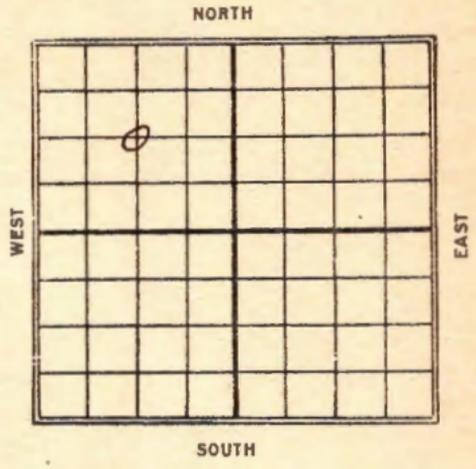

1929


Date REPORT

Date	REPORT
8/28	Poly
9/4	Rign up
9/11	Spind
9/18	—
9/25	SD
10/2	SD 350'
10/9	—
10/16	Wg 390
10/23	SD 390'
10/30	—
11/6	—
11/13	—
11/20	—
11/27	—
12/4	—
12/11	—
12/18	—
12/23	—
12/30	Ply out 390'
1930	
1/8	dry 16" - 425' dry on
1/15	dry 520'

1/22 - S.D. 520'  
1/29 - set 15" - 840'  
2/5 - No report  
2/12 - Shut down 840'  
2/19 - \_\_\_\_\_  
2/26 - \_\_\_\_\_  
3/5 - \_\_\_\_\_  
3/12 - \_\_\_\_\_  
3/19 - Hrlg 1475'  
3/26 - S. D. 1475'  
4/2 - \_\_\_\_\_  
4/9 - No report  
4/16 - Hrlg 2005'  
4/23 - " 2250'  
4/30 - No report.  
5/7 - \_\_\_\_\_  
5/14 - \_\_\_\_\_  
5/21 - Hrlg. 3095'  
5/28 - No report  
6/4 - Hrlg. 3440'  
6/11 - U/H. 8" 3440'  
6/18 - Hrlg. 3575'  
6/25 - No report  
7/2 - \_\_\_\_\_  
7/9 - \_\_\_\_\_  
7/16 - \_\_\_\_\_  
7/23 - \_\_\_\_\_

Map No. KANSAS Sec. 21 Twp. 25 R. 24<sup>W</sup>  
 Well No. 1-Hawthorne Farm  
Swain et al. Company

1320 Ft. from N. Line  
 \_\_\_\_\_ Ft. from S. Line  
 \_\_\_\_\_ Ft. from E. Line  
1320 Ft. from W. Line

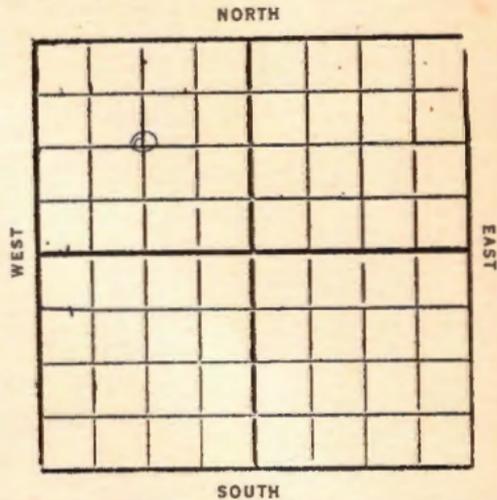

1932


**OWDD** REPORT

Date	Notes
2/3	Old TD 5105' 1/2" 5"
2/10	—
2/17	—
2/26	—
3/2	—
3/9	SD 5105'
3/16	—
3/22	—
3/30	—
4/6	—
4/13	—
4/20	—
4/27	—
5/4	—
5/11	—
5/18	—
5/25	—
6/1	—
6/8	TD 5105' wreg up bailer
6/15	—
6/22	—
6/29	—

- 7/6 - SD 5105'
- 7/13 - dreg 5220'
- 7/20 - SD 5220'
- 7/27 - —
- 8/3 - —
- 8/10 - —
- 8/17 - —
- 8/24 - set 3" tubing at 5187  
 Sand 5205-09  
 TD 5209  
 5000 ft water in hole
- 8/31 - <sup>SD</sup> dreg 5220'
- 9/7 - " 5320'
- 9/14 - " 5405'
- 9/21 - " 5427'
- 9/30 - Report show oil and gas  
 at 5505'
- 10/5 - 4"-5505  
 HFW 5517-25  
 SD 5525'
- 10/12 - TD 5525 Well V1R 4"
- 10/19 - dreg 5610'
- 10/26 - " 5660'
- 11/2 - " 5735'
- 11/9 - Top Silic 5666  
 HFW 5772  
 dreg 5782'
- 11/16 - SD 5782'
- 11/23 - Top Silic lime 5666  
 HFW 5772  
 TD 5782  
 Abandon

Map No. \_\_\_\_\_ Sec. 21 Twp. 25 R. 24<sup>w</sup>  
 Well No. 1 - Hawthorn Farm  
Swain et al Company

1320 Ft. from N. Line  
 \_\_\_\_\_ Ft. from S. Line  
 \_\_\_\_\_ Ft. from E. Line  
1320 Ft. from W. Line

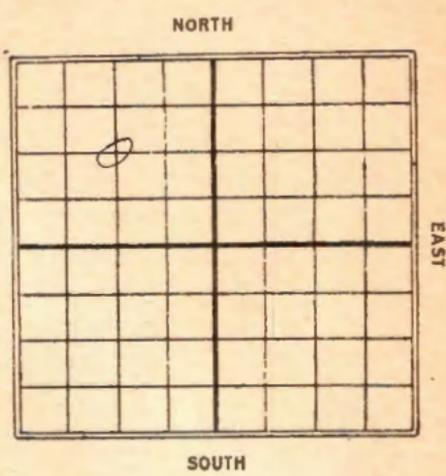

1930

Date	REPORT
7/30	Repair rig 3555'
8/6	_____
8/13	_____
8/20	Dry 3610'
8/27	_____
9/3	6" - 3755'
9/10	S.D. 3755'
9/17	dry 3755'
9/24	No report
10/1	_____
10/8	Dry 4200'
10/15	No report
10/22	_____
10/29	Dry 4300'
11/5	No report
11/12	S.D. 4300'
11/19	dry ahead
Information withheld	
11/25	_____ 12/23 _____
12/3	_____ (over)
12/10	_____
12/17	_____

12/30- 6"-4308  
 T.D. 4315' Dry out  
 1931  
 1/17 No report  
 1/14 —  
 1/21- Sit 5"-4320  
 1/28- SD. 4321 repairs  
 2/4- drly 4400'  
 2/11- " 4415'  
 2/18- " 4490'  
 2/25- " 4575'  
 3/4- " 4610'  
 3/11- No report  
 3/18- 5"-4600  
 drly 4620'  
 3/25- " 4700'  
 4/11- No report  
 4/8- drly 4730'  
 4/15- SD. 4730'  
 4/22- 5"-4745  
 drly 4753  
 4/29- " 4790'  
 5/6- " 4880'  
 5/13- " 5038'  
 5/20- " 5105'  
 5/27- SD. 5105'  
 6/3 — 8/5 —  
 6/10 — 8/12 —  
 6/17 — 8/19 —  
 6/24 — 8/26 —  
 7/1 — 9/2 —  
 7/8 — 9/9 —  
 7/15 — 9/15- TD. 5105  
 7/22 — Dry + abandon  
 7/29 —

Map No. *86* **KANSAS** Sec. *21* Twp. *25* R. *24W*

Well No. *1 Northern*

*Swain & Co* Company

Contractor


SECTION PLAT

*1320* Ft. from N. Line

..... Ft. from S. Line

..... Ft. from E. Line

*1320* Ft. from W. Line

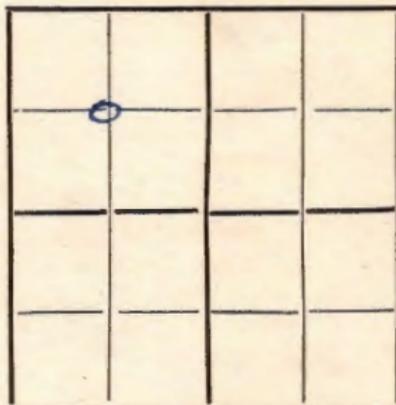

**FIRST REPORTS**

Location.....

Rig up.....

Drilling and Remarks:

*RAY*

**RECORD**

Cased.....in., .....ft.

Sand.....

Gas.....

Oil.....

Total Depth.....

**PRODUCTION**

1st 24 hrs. Nat.....

1st 24 hrs. after shot.....

Gas..... Cu. Ft.

Dry Hole.....

Abandoned.....

Date

**AUG 28 1929**

192.....

**S. J. LEWIS** Scout

*Few*

**KANSAS**

Map No. \_\_\_\_\_ Sec. *21* Twp. *25* R. *24*<sup>w</sup>

Well No. *86 1 Henshaw*

*Swain et al* Company

Contractor

**COMPLETED**

**SECTION PLAT**

*1320* Ft. from N. Line

\_\_\_\_\_ Ft. from S. Line

\_\_\_\_\_ Ft. from E. Line

*1320* Ft. from W. Line

	o		

**ABANDONED**

Location \_\_\_\_\_

Rig up \_\_\_\_\_

Drilling and Remarks:

**RECORD**

Cased \_\_\_\_\_ in., \_\_\_\_\_ ft.

Sand \_\_\_\_\_

Gas \_\_\_\_\_

Oil \_\_\_\_\_

Total Depth *5105*

**PRODUCTION**

1st 24 hrs. Nat. \_\_\_\_\_

1st 24 hrs. after shot \_\_\_\_\_

Gas \_\_\_\_\_ Cu. Ft.

Dry Hole *✓*

Abandoned *✓*

Date

**SEP 1 6 1931**

**CHAS. L. SHERWOOD**  
192 \_\_\_\_\_ Scout

**SEP 1 6 1931**

Ford

W

86 KANSAS Map No. Sec. 21 Twp. 75 R. 24

Well No. 1 Henthorn

Swain Coal Company

Contractor

COMPLETED


SECTION PLAT

1370 Ft. from N. Line

Ft. from S. Line

Ft. from E. Line

1370 Ft. from W. Line

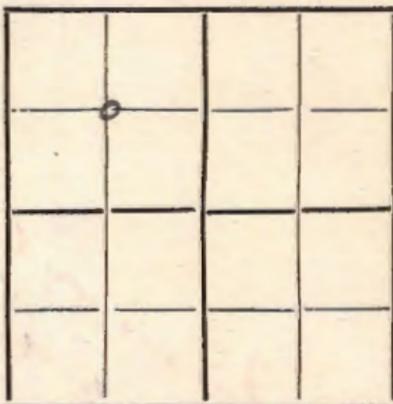

ABANDONED

Location

Rig up

Drilling and Remarks:

Top Sili 5666  
HFV 5772

RECORD

Cased in., ft.

Sand

Gas

Oil

Total Depth 5782

PRODUCTION

1st 24 hrs. Nat.

1st 24 hrs. after shot

Gas Cu. Ft.

Dry Hole ✓

Abandoned ✓

Date

NOV 23 1932 CHAS. L. SHERWOOD

Scout

Ford

KANSAS

Map No. \_\_\_\_\_ Sec. 21 Twp. 25 R. 24 W


Well No. 1 Hawthorn

Swain et al Company

Contractor

FIRST REPORTS

SECTION PLAT

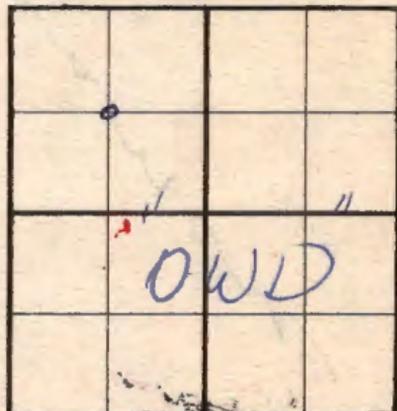

1320 Ft. from N. Line

\_\_\_\_\_ Ft. from S. Line

\_\_\_\_\_ Ft. from E. Line

1320 Ft. from W. Line

Location \_\_\_\_\_

Rig up \_\_\_\_\_

Drilling and Remarks:

TD 5105

UIR 5"

RECORD

Cased \_\_\_\_\_ in., \_\_\_\_\_ ft.

Sand \_\_\_\_\_

Gas \_\_\_\_\_

Oil \_\_\_\_\_

Total Depth \_\_\_\_\_

PRODUCTION

1st 24 hrs. Nat. \_\_\_\_\_

1st 24 hrs. after shot \_\_\_\_\_

Gas \_\_\_\_\_ Cu. Ft.

Dry Hole \_\_\_\_\_

Abandoned \_\_\_\_\_

Date

FEB 3 1932

19

CHAS. L. SHERWOOD

Scout