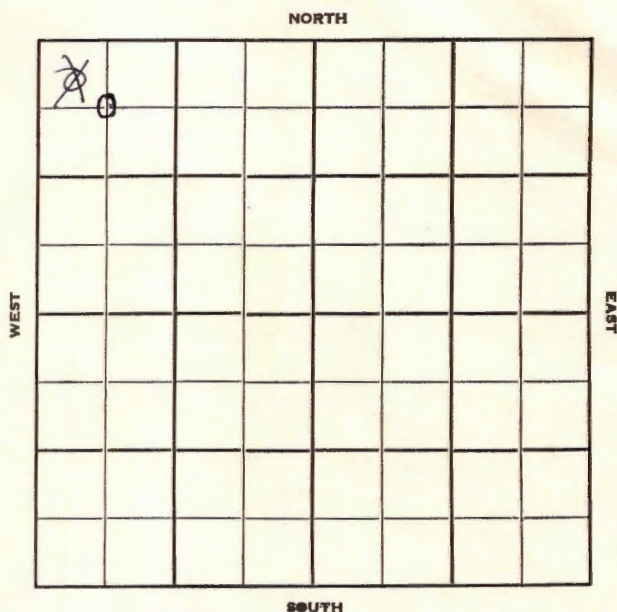


Section 22 Township 25 Range 25WWell No. #1 RoseCompany Kingwood Oil

Ford

KANSAS

Sec. 22 Twp. 25 R. 25 W

Well No. # 1 Rose Farm ☒

- Kingwood Oil Company

Spear Drlg. Contractor


Wildcat

660'
330 Ft. from N. Line

_____ Ft. from S. Line

_____ Ft. from E. Line

660'
330 Ft. from W. Line

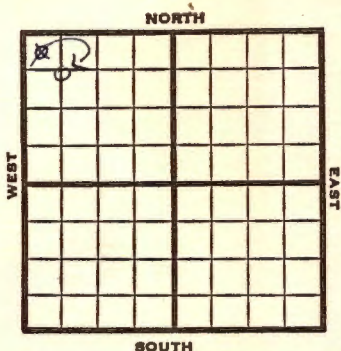

C NW NW NW

PEPL - DHM

1951

Elev. 2573' REPORT

4/25

Spud 4-20-51

8-5/8" @ 173

Drlg. 2465'

Anhy 1355'

5/29

Spud 4-20-51

D&A TD 5815

8-5/8" @ 173'

Anhy 1355

Top 3745

Lans. 4250

DST 4517-35 opn 1 hr

Rec. 340' gcm & wtr Miss 4951

DST 4975-92 opn 1 hr Rec. 90' mud

Viola 5484

DST 5485-5505 opn 4 hr. Rec. 1000' mud


780' wtr Arb. 5711

DST 5719-5815 opn 50 min Rec. 3800'

sw 200' mud TD 5815

D&A

ABANDONED

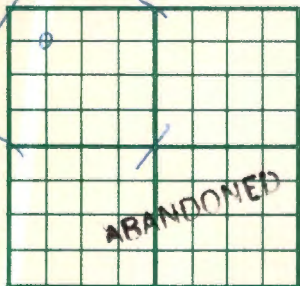County Ford State KansasSec. 22 (Blk. 25) (Sur. 25W) Map No. 25WOperator Kingwood OilWell No. 1 Farm RoseElev. 2573 Location C NW NW660 Ft. From N Line NW660 Ft. From W Line Quarter

1st. Report

Completion MAY 20 1951Remarks WildcatSpeer Drlg. - Contr.Spudding Date 4-20-51Drlg. Data D & A TD 58158 5/8" @ 173 Anhy 1355 Top. 3745Lans. 4250 DST 4517-35 open 1 hr.Rec. 340' gcm & water Miss. 4951DST 4975-92 open 1 hr. Rec. 90' mudViola 5484 DST 5485-5505 open 4 hr.Rec. 1000' mud 780' water Arb. 5711DST 5719-5815 open 50 min. Rec. 3800' sw200' mud TD 5815D & A

J. E. TYRA

County **Ford** State **Kansas**Sec. **22** (Blk. Twp.) **25** (Sur. Rge.) **25W** Map No.Operator **Kingwood Oil**Well No. **1** Farm **Rose**Elev. Location **NW NW NW**

0					

FIRST REPORT**330** Ft. From **N** Line **NW****330** Ft. From **W** Line Quarter1st. Report **APR 25 1951**

Completion

Remarks **PEPL - DHM****Spear Drlg. - Contr.**Spudding Date **4-20-51**Drlg. Data **Wilcoat****8 5/8" @ 173 Anhy 1355 drlg. 2465****J. E. TYRA**

Kansas

Map No. _____ Sec. 22 Twp. 25 R. 25WWell No. 1 Rose

Kingwood Oil

Company

~~CORRECTION~~

Contractor

C NW NW

SECTION PLAT

660 Ft. from N. Line

_____ Ft. from S. Line

_____ Ft. from E. Line

660 Ft. from W. Line

o			

Ford County

Location _____

Rig up _____

Drilling and Remarks:

Reported

NW NW NW

RECORD

Cased _____ in., _____ ft.

Sand _____

Gas _____

Oil _____

Total Depth _____

PRODUCTION

1st 24 hrs. Nat. _____

1st 24 hrs. after shot _____

Gas _____ Cu. Ft.

Dry Hole _____

Abandoned _____

Date

MAY 2 1951 19

J. E. TYRA Scout