


Finney Kansas

Section 7 Township 25 Range 31WWell No. 1 Frank ReedCompany Skelly Oil & Magnolia Pet

NORTH

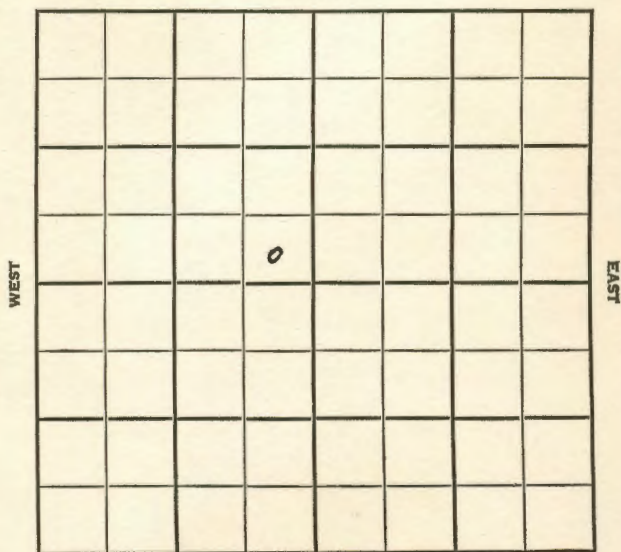

SOUTH

KANSAS

SEC. TWP. R.

7 25 31 W

1 Frank Reed FARM

COMPANY

Skelly Oil & Magnolia Pet.

CONTRACTOR

NORTH


Ft. from N. Line

330 Ft. from S. Line

330 Ft. from E. Line

Ft. from W. Line

SE SE NW

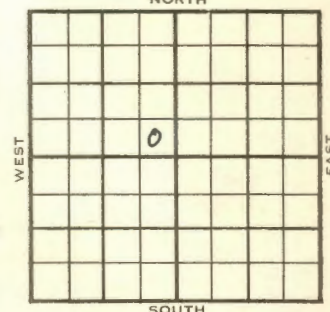

SOUTH

	ELEVATION	REPORT
1954	2806'	
5/26	Location	
6/2	RUR	
6/9	8" @ 502'	
	Hol 2477', Her 2537'	
	RTD 2545'	
	7" @ 2537'	
10/6	Spud 5-30-54 Gas well TD 2602	
	8" @ 502' Hol. 2477 Her. 2537	
	TD 2545 7" @ 2537 DD 2560 62,000	
	gas. DD 2590 DD 2593 Kri. 2571	
	Odell 2590 PB 2594 frac 295,000 gas	
	25 GWPH PB 2588 frac 1,620,000 CFG	
	Win. 2592' TD 2602 PB 2591	
	4000 A 1 MCFG 1 1/2 BWPH PB 2585	
	762,000 CFG 70 GWPH PB 2582	
	2000 A 1,630,000 CFG	
	Comp. 354,000 CFGPD	
	COMPLETED	

