


DX 78-1

Finney KANSAS

Section 18 Township 25 Range 31WWell No. 1 Hicks "C"Company Petroleum, Inc. & Skelly Oil

NORTH

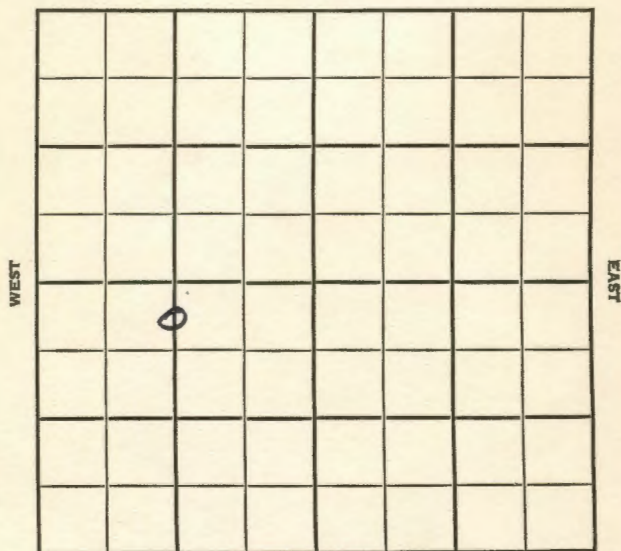

SOUTH

Finney KANSAS

SEC. 18 TWP. 25 R. 31WWELL NO. 1 Hicks "C" FARMCOMPANY Petr., Inc. & Skelly OilCONTRACTOR Hugoton Pool

330 Ft. from N. Line


Ft. from S. Line

1320 Ft. from E. Line

Ft. from W. Line

C N/2 N/2 SW

NORTH

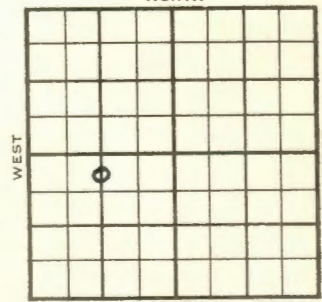

SOUTH

1954

ELEVATION

2822'

REPORT

11/23

Spud 11-12-54

8" @ 397'

TD 2598'

5" @ 2596', WOC

12/29

Spud 11-12-54 - Gas Well

TD 2614'

8" @ 397'

Her. 2532', Kri 2566', Win. 2588'

TD 2598'

5" @ 2596'

DD 2614' 4500 A

350,000 cfg

A-frac

21/2540-75, 1000A

1,000,000 cfg

Comp. 5,030,000 cfgpd

COMPLETED

DX-78

County **Finney** State **Kansas**
 Sec. **18** (Blk. Twp.) **25** (Sur. Rge.) **31W** Map No.
 Operator **Petroleum Inc. & Skelly Oil**
 Well No. **1** Farm **Hicks "C"**
 Elev. **2822** Location **C N $\frac{1}{2}$ N $\frac{1}{2}$ SW**




330 Ft. From N Line SW
1320 Ft. From W Line Quarter
 1st. Report
 Completion **DEC 29 1954**
 Remarks **Hugoton Pool**

Spudding Date **11-12-54**

Drig. Data **Gas well TD 2614**
8" @ 397 Her. 2532 Kri. 2566
Win. 2588 TD 2598 5" @ 2596
DD 2614 4500 A 350,000 cfg A-frac
21/ 2540-75 1000 A 1,000,000 cfg
Comp. 5,030,000 cfgpd

FABEN GILSTRAP

County **Finney** State **Kansas**
 Sec. **18** (Blk. Twp.) **25** (Sur. Rge.) **31W** Map No.
 Operator **Petroleum Inc & Skelly Oil**
 Well No. **1** Farm **Hicks "C"**
 Elev. Location **C N $\frac{1}{2}$ N $\frac{1}{2}$ SW**

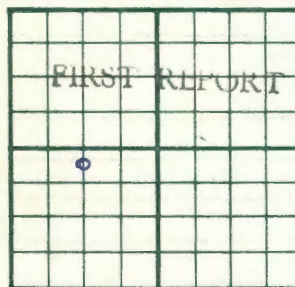

330 Ft. From N Line SW
1320 Ft. From W Line Quarter
 1st. Report **NOV 23 1954**
 Completion
 Remarks

Spudding Date **11-12-54**

Drig. Data **Hugoton Pool**
8" @ 397 TD 2598 5" @ 2596 WOC

FABEN GILSTRAP