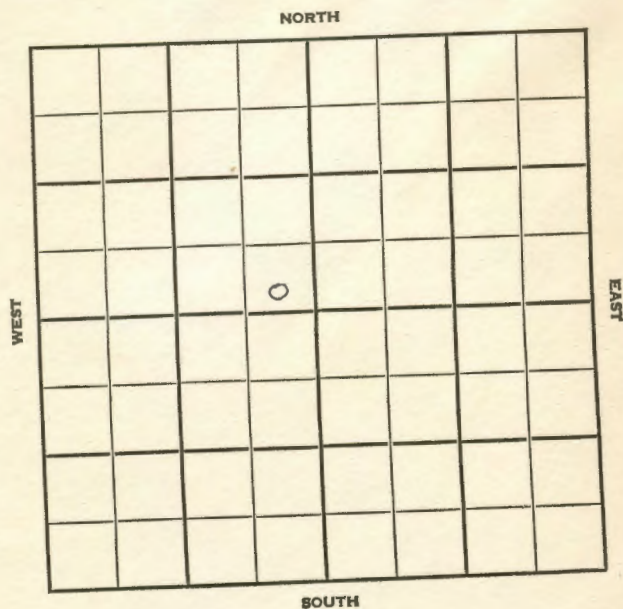


DX 78-1 **FINNEY****KANSAS**Section **28** Township **25** Range **31W**Well No. **5 Beach**Company **Draper Motors**

Finney **KANSAS**

SEC.	TWP.	R.
28	25	31 W

WELL NO.

#5 Beach

FARM

COMPANY

Draper Motors

CONTRACTOR

Michaelis
Hugoton Pool

Ft. from N. Line

150


Ft. from S. Line

350

Ft. from E. Line

Ft. from W. Line

SE SE NW

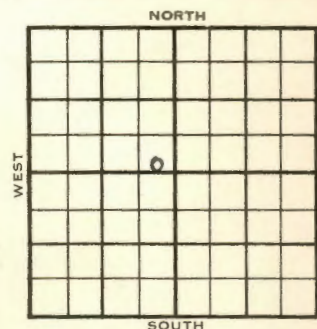

Continental FO

	ELEVATION	REPORT
1955	2840'	

3/30

Spud 3-27-55

8" @ 537

Drlg.

4/20

Spud 3-27-55 - Gas Well

TD 2670'

8" @ 537'

Her. 2630'

TD 2635'

5" @ 2633'

DD 2665' frac

2,800,000 cfgpd

DD 2670' frac

Comp. 1,849,000 cfgpd

COMPLETED

DX-78

