



DX 78-1 **O.W.D.D** Finney KANSAS
 Section 20 Township 25 Range 31W
 Well No. #3 Beach
 Company Draper Motors.

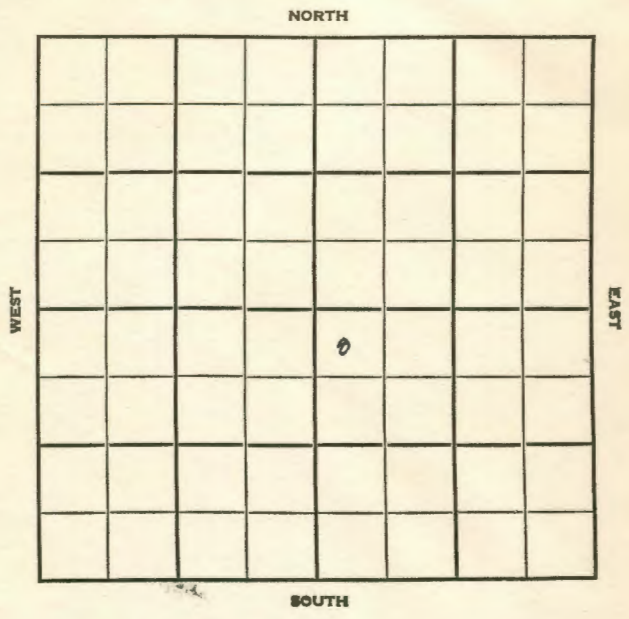

O.W.D.D

O.W.D.D Finney KANSAS
 SEC. 20 TWP. 25 R. 31W
 WELL NO. #3 Beach FARM
 COMPANY Draper Motors.
 CONTRACTOR Michaelis

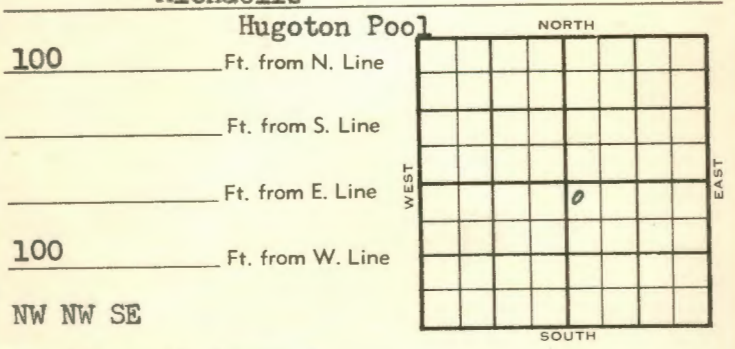

NW NW SE
Continental Farmout

	ELEVATION	REPORT
1955	2838'	
3/2	Spud 2-26-55 8" @ 536' Drlg. 1985'	
3/16	Spud 2-26-55, Gas Well, TD 2635' 8" @ 536, Her 2592, Kri 2618, TD 2595, 5" @ 2593, DD 2618, DD 2635 240,000 CFG frac Comp 2,200,000 CFGPD	
1955		
3/30	COMPLETED O.W.D.D Her 2592', Kri. 2618' OTD 2635' 5" @ 2593 To DD	
4/20	Gas Well - TD 2666' Her. 2592', Kri. 2618' OTD 2635' 5" @ 2593' DD 2666' Comp. 1,800,000 cfgpd	
		COMPLETED

County **Finney** State **Kansas**
 Sec. **20** (Blk. Twp.) **25** (Sur. Rge.) **31W** Map No.
 Operator **Draper Motors**
 Well No. **3** Farm **Beach**
 Elev. **2838** Location **NW NW SE**

O.W.D.D.
 100 Ft. From **N** Line **SE**
 100 Ft. From **W** Line Quarter
 Ist. Report **MAR 30 1955**
 Completion **O.W.D.D. OWDD**
 Remarks **Continental farmout**
 Spudding Date

Drig. Data **Hugton Pool**
Her. 2592 Kri. 2618 OTD 2635
5" @ 2593 to DD

FABEN GILSTRAP

County **Finney** State **Kansas**
 Sec. **20** (Blk. Twp.) **25** (Sur. Rge.) **31W** Map No.
 Operator **Draper Motors**
 Well No. **3** Farm **Beach**
 Elev. **2838** Location **NW NW SE**

COMPLETE
 100Ft. From **N** Line **SE**
 100Ft. From **W** Line Quarter
 Ist. Report
 Completion **MAR 16 1955**
 Remarks **Hugton Pool**
Michaelis - Contr.
 Spudding Date **2-26-55**

Drig. Data **Gas well TD 2635**
8" @ 536 Her. 2592 Kri. 2618
TD 2595 5" @ 2593 DD 2618 DD 2635
240,000 cfg frac
Comp. 2,200,000 cfgpd

FABEN GILSTRAP

