

HOT FILE Finney KANSAS

SEC. 32 TWP. 25 S R. 31 W

WELL NO. #1 Beach FARM

COMPANY Michaelis Drlg.--Oper

CONTRACTOR Skelly Oil Co. & SDX--Non Oper.

Hugoton 2490 FT. FROM N. LINE

FT. FROM S. LINE

FT. FROM E. LINE

1320 FT. FROM W. LINE

C S $\frac{1}{2}$ S $\frac{1}{2}$ NW

150' N of C of W/2 of Sec.

SDX- $\frac{1}{4}$ Int. Mid-States AC

OPERATING AGREEMENT (Proposed Gas Unit)

1956 ELEVATION 2819' REPORT (WH6-EX8) ✓

5/8 Letter 5-8-56 referring to Proposed Gas Unit, Sec. 32-25S-31W, Finney Co. Kansas between Michaelis Drlg. Co, Skelly Oil & SDX.-- (No copy of Oper. Agt. rec'd by Scouting Dept.)

3/14 Comm. 3-12-56 8-5/8" @ 507/300 (FR Tkt)

2/22 TD 2677' 5 $\frac{1}{2}$ " @ 2676/400 WOC

4/4 Comm. 3-12-56 8-5/8" @ 507/300

5 $\frac{1}{2}$ " @ 26x70/400

CO 4/2643-44 56/2622-36 48/2598-2608'. Frac.

TD 2677' Comp. 8,983 MCFGPD

Tops: Herr. 2570', U. Kri 2595',

L. Kri 2619', Wafd 2668'

COMPLETED ✓

WH6-EX8 ✓


Finney

KANSAS

SECTION 32 TOWNSHIP 25 S RANGE 31 W

WELL NO. #1 Beach

COMPANY Michaelis & Oil Trading SDX $\frac{1}{4}$ INT.

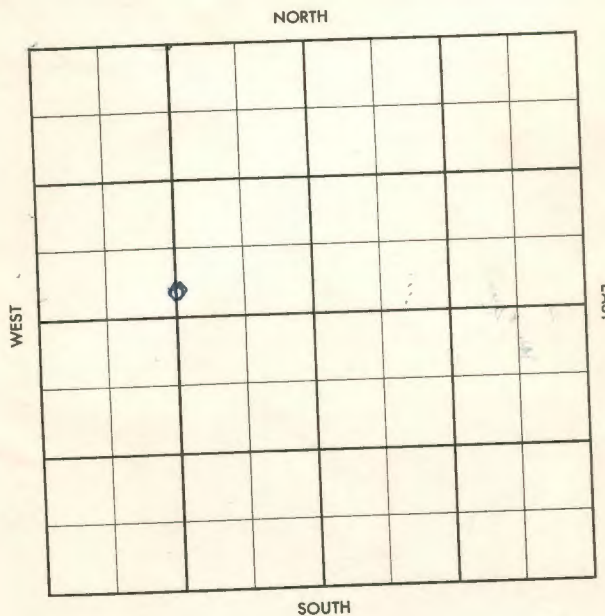

WEST

EAST

SOUTH

FORM 513 REV. SUNRAY

County Finney Elev. 2819
 Sec. 32 Twp. 25 Rge. 31W
 Company Michaelis Drlg. & Oil Trading
 FarmName Beach No. 1

TOPS	DEPTH	LOG	DATUM	Loc. in Sec.
Anh.				C S ¹ S ¹ NW
Tp. <u>Herr</u>		<u>2570</u>		
H. <u>L. Kri</u>		<u>2595</u>		
Tr. <u>L. Kri</u>		<u>2619</u>		
Dg. <u>Wfd</u>		<u>2668</u>		
BL.				
L.				Geol.
K.C.				Contr.
B.K.C.				
Ce.				
C.				
M.				
M.				Pool
K.				<u>Hugoton</u>
Mz.				
Me.				
V.				
S.				
S.				
A.				
R.				
Pe.				
G.				
T.D.		<u>2677</u>		

COMPLETE
 APR 4 1956

Date Comm. 3-12-56
8 5/8" @ 507/300 5 1/2" @ 2670/400 CO
11/ 2613-111 56/ 2622-36 48/ 2598-2608
frac Comp. 8,983 mcfgpd

FORM 513 REV. SUNRAY

County Finney Elev. 31W
 Sec. 32 Twp. 25 Rge. 31W
 Company Michaelis & Oil Trading
 FarmName Beach No. 1

TOPS	DEPTH	LOG	DATUM	Loc. in Sec.
Anh.				<u>2490' NL</u>
Tp.				
H.				<u>1320' WL</u>
Tr.				
Dg.				
BL.				Geol.
L.				Contr.
K.C.				
B.K.C.				
Ce.				
C.				
M.				Pool
M.				<u>Hugoton</u>
K.				
Mz.				
Me.				
V.				
S.				
S.				
A.				
R.				
Pe.				
G.				
T.D.				

REPORT
 MAR 14 1956

Date Comm. 3-12-56 Mid-States AC
8 5/8" @ 507/300

35