

Finney **KANSAS**

SEC. 33 TWP. 25 R. 31 W

WELL NO. # 2 Beach FARM

COMPANY Michaelis & Oil Trading


CONTRACTOR Michaelis
Hugoton

_____ Ft. from N. Line

_____ Ft. from S. Line

_____ Ft. from E. Line

_____ Ft. from W. Line

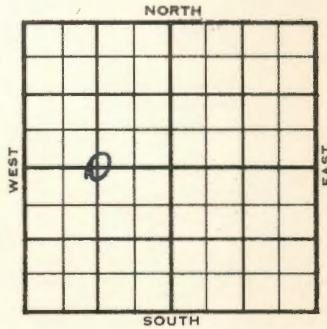

C W $\frac{1}{2}$

SDX -1/4 Mile

Cont. FO

1956	ELEVATION	REPORT
	2835	

3/21	Comm. 3-17-56 8" @ 508/300 Drlg. 2390'
3-29	Herr. 2604 U.Kri. 2619 L. Kri 2652 Winf. 2698 4 $\frac{1}{2}$ " @ 2700/800
4-5	CO, 48/ 2632-44, 48/2656-68, Frac, 2500 mcfg.
4-11	Comp. 4,223 mcfgpd TD 2702'

COMPLETED


DX 78-1 Finney

KANSAS

Section 33 Township 25 Range 31W

Well No. # 2 Beach

Company Michaelis & Oil Trading

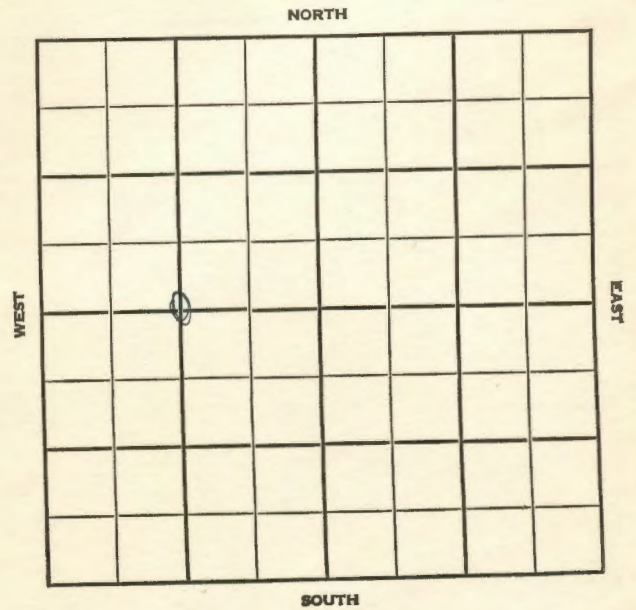

County Finney Elev. 2835
 Sec. 33 Twp. 25 Rge. 31W
 Company Michaelis & Oil Trading
 FarmName Beach No. 2

TOPS	DEPTH	LOG	DATUM	Loc. in Sec.
Anh. <u>Peri</u>		<u>2604</u>		C W ¹ Sec.
Tr. <u>2 Kri</u>		<u>2619</u>		
H. <u>2 Kri</u>		<u>2652</u>		
Tr. <u>wfd</u>		<u>2698</u>		
Dg.				
Bl.				
L.				
K.C.				Geol.
B.K.C.				Contr
Ce.				<u>Michaelis</u>
C.				
M.				Pool
M.				<u>Hugoton</u>
K.				
Mz.				
Mo.				
V.				
S.				
S.				
A				
R.				
Pe.				
G.				
T.D.	<u>2202</u>			

Date Comm. 3-17-56 APR 11 1956
 8" @ 508/300 4 1/2" @ 2700/800
 CO 48/2632-44 48/2656-68
 frac 2,500 mcfg Comp. 4,223 mcfgpd

County Finney Elev. _____
 Sec. 33 Twp. 25 Rge. 31W
 Company Michaelis & Oil Trading
 FarmName Beach No. 2

TOPS	DEPTH	LOG	DATUM	Loc. in Sec.
Anh.				C W ¹
Tr.				
H.				
Tr.				
Dg.				
Bl.				
L.				
K.C.				Geol.
B.K.C.				Contr
Ce.				<u>Michaelis</u>
C.				
M.				Pool
M.				<u>Hugoton</u>
K.				
Mz.				
Mo.				
V.				
S.				
S.				
A				
R.				
Pe.				
G.				
T.D.				

Date Comm. 3-17-56 Cont. FO
 8" @ 508/300 drlg. 2390

FIRST REPORT
 50X - 1/4 mile
 MAR 21 '56

~~25~~