

Finney KANSAS


SEC. 29 TWP. 25 R. 31 W

WELL NO. # 4 Beach FARM

COMPANY Draper Motors

CONTRACTOR Michaelis Hugeton Pool

150 Ft. from N. Line
250 Ft. from S. Line
Ft. from E. Line
Ft. from W. Line

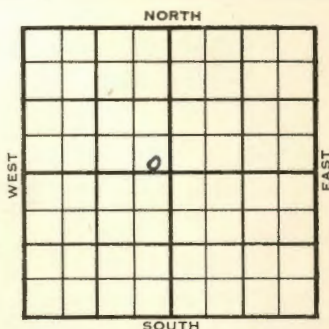

SE SE NW

Continental FO

1955 ELEVATION REPORT

3/30 Spud 3-16-55
8" @ 552 TD 2600 5" @ 2598
DD 2635 158,000 CFG frac.
1,740,000 CFG

4/20 Spud 3-16-55 - Gas Well
TD 2665'
8" @ 552'
TD 2600'
5" @ 2598'
DD 2635', 158,000 cfg, frac
1,740,000 cfg
Her. 2596', Kri 2620', Win. 2654'
DD 2665'
4" @ 2665'
2000A
Comp. 1,740,000 cfcpd

COMPLETED


DX 78-1 FINNEY

KANSAS

Section 29 Township 25 Range 31W

Well No. 4 Beach

Company DRAPER Motors

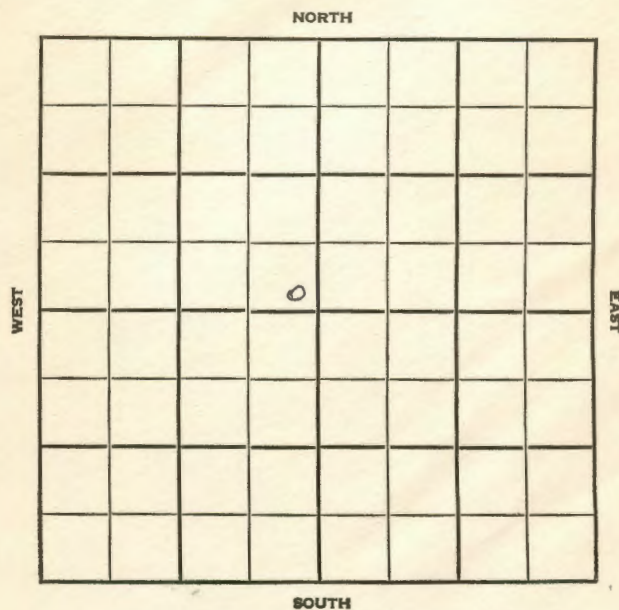

FABEN GILSTRAP

FABEN GILSTRAP