


DX 78-1

Finney KANSAS

Section 30 Township 25 Range 31W
 Well No. 2 Veach
 Company Draper Motors

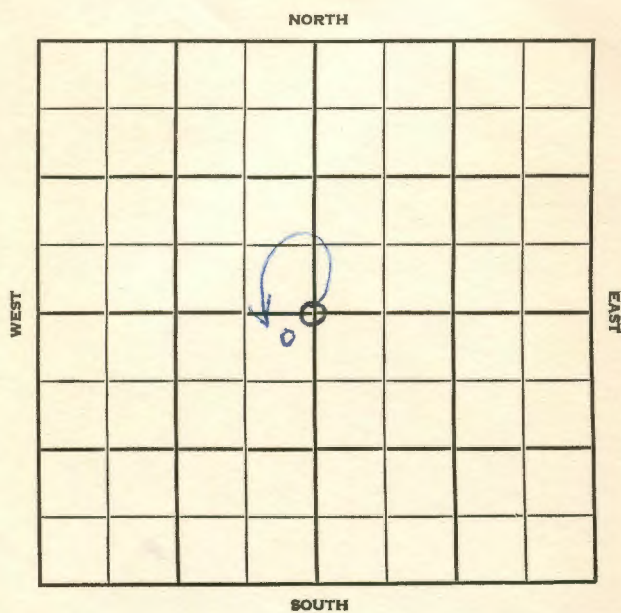

Finney

KANSAS

SEC. 30 TWP. 25 R. 31W
 WELL NO. #2 Veach FARM
 COMPANY Draper Motors.
 CONTRACTOR

Bill Graham

Hugoton Pool

~~2640~~ 200 Ft. from N. Line

Ft. from S. Line


~~2640~~ 200 Ft. from E. Line

Ft. from W. Line

NE NE S W

~~6 Sec.~~

Cont'l F/O

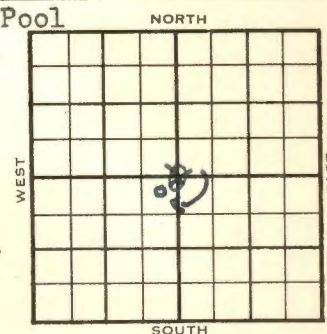

1955

ELEVATION
2841'

REPORT

1/26

Spud 1-22-55
 8" @ 565'
 WOC

3/2

Spud 1-22-55 - Gas Well
 TD 2620'
 8" @ 565'
Her. 2581', Kri 2608'
 TD 2585'
 5" @ 2582'
 DD 2620', 6000A
 Comp. 2,500,000 cfcpd

COMPLETED

DX-78

County **Finney** State **Kansas**
 Sec. **30** (Blk. **25** (Sur. **31W** Map No.
 Operator **Draper Motors**
 Well No. **2** Farm **Veach**
 Elev. **2841** Location **NE NE SW**

COMPLETE
 200 Ft. From **N** Line **SW**
 200 Ft. From **E** Line **Quarter**
 1st. Report
 Completion **MAR 2 1955**
 Remarks **Hugoton Pool**
Bill Graham - Contr.
 Spudding Date **1-22-55**
 Drlg. Data **Gas well TD 2620**
8" @ 565 Her. 2581 Kri. 2608
TD 2585 5" @ 2582 DD 2620 6000 A
Comp. 2,500,000 cf gpd

FABEN GILSTRAP

County **Finney** State **Kansas**
 Sec. **30** (Blk. **25** (Sur. **31W** Map No.
 Operator **Draper Motors**
 Well No. **2** Farm **Veach**
 Elev. Location **C Sec.**

FIRST REPORT
 2640 Ft. From **N** Line **Sec.**
 2640 Ft. From **E** Line **Quarter**
 1st. Report **JAN 26 1955**
 Completion
 Remarks **Cont'l farmout**
Bill Graham - Contr.
 Spudding Date **1-22-55**
 Drlg. Data **Hugoton Pool**
8" @ 565 WOC

FABEN GILSTRAP

SCOUT TICKET

DX-201

K-11001

SEC.	30	TWP.	25	R.	31W
------	----	------	----	----	-----

WELL NO.

2 Veach

FARM

COMPANY

Draper Motor

CONTRACTOR

CORRECTION

NE NE SW


200 FT. FROM N. LINE

FT. FROM S. LINE

200

FT. FORM E. LINE

FT. FROM W. LINE

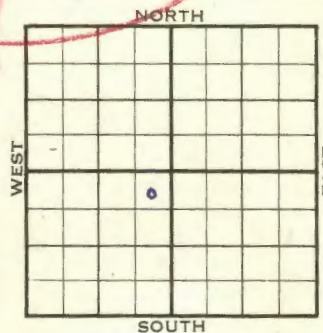

Finney County

☐ LOCATION☐ RIG UP

DRILLING AND REMARKS:

Reported
C Sec.

RECORD

CASED IN., FT.

SAND

GAS

OIL

TOTAL DEPTH

PRODUCTION

1ST 24 HRS. NAT.

1ST 24 HRS. AFTER SHOT

GAS CU. FT.

DRY HOLE

ABANDONED

DATE

MAR 2 1955

SCOUT

FABEN GILSTRAP